
DX 78-1 Butler KANSAS

Section 6 Township 23 Range 4 E

Well No. #2 Hawk Heirs

Company Beaumont Pet.

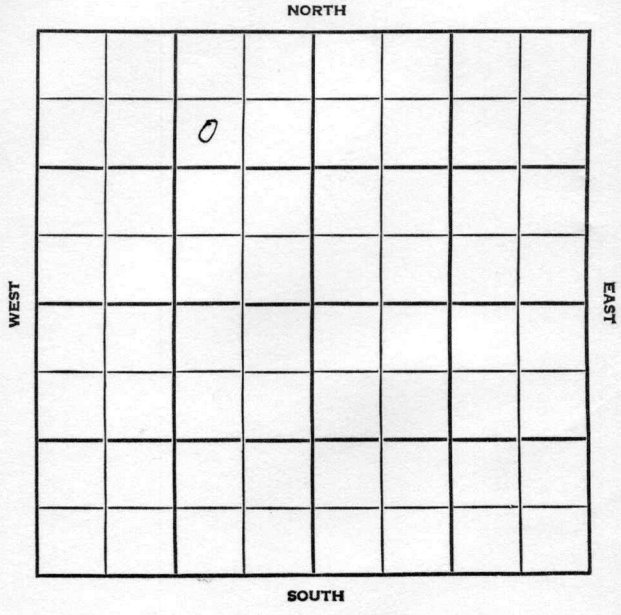

~~Marion~~ Butler KANSAS

SEC.	TWP.	R
6	23	4E

WELL NO.
#2 Hawk Heirs FARM

COMPANY
Beaumont Pet.

CONTRACTOR
Co. Tools
Edmonds


990 Ft. from N. Line

_____ Ft. from S. Line

990 Ft. from E. Line

_____ Ft. from W. Line

SW NE NW

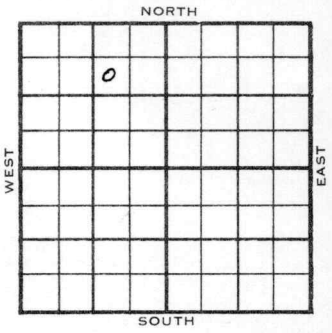

1955	ELEVATION 1408'	REPORT
8/31	Location Comm 8-25-55 10" @ 86/90 Drlg 1200	
10/5	Comm 8-25-55 10" @ 86/90 7" @ 2468/50 L BKC Marm C Chert TD DD 2471 wtr PB 2468 HFW D & A	1902 2273 2335 2462 2465 2466 27/2465-68 frac ABANDONED

DX-78

Butler Co,

FORM 513 REV. SUNRAY ~~Butler~~ Marion

County Marion Elev.

Sec. 6 Twp. 23 Rge. 4E

Company Beaumont Pet.

Farm Name Hawk Heirs No. 2

TOPS	DEPTH	LOG	DATUM
Anh.			
T.P.			
H.			
Tr.			
Dg.			
B.L.			
L.			
K.C.			
B.K.C.			
Ce.			
C.			
M.			
M.			
K.			
Mz.			
Mo.			
V.			
S.			
S.			
A			
R.			
P€.			
G.			
T.D.			

Loc. in Sec. SW NE NW

Geol.

Contr. Co. tools

Pool Edmonds



Date Comm. 8-25-55

10" @ 86/90 drlg. 1200

23S 4E - IN Butler Co.

Co. Lse. No. Sec. T. R.

SCOUT TICKET DX-201

Kansas

SEC.	TWP.	R.
6	23	4E

WELL NO.

2 Hawk Heirs — FARM

COMPANY

Beaumont Pet.

CONTRACTOR

CORRECTION


SW NE NW

990 FT. FROM N. LINE

_____ FT. FROM S. LINE

990 FT. FORM E. LINE

_____ FT. FROM W. LINE

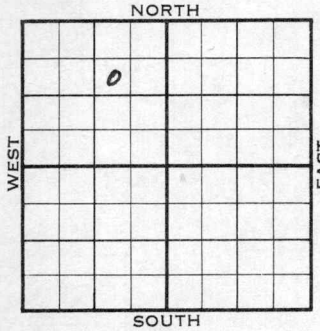

Butler County

☐ LOCATION

☐ RIG UP

DRILLING AND REMARKS:

Reported
Marion County

RECORD

CASED IN., FT.
SAND
GAS
OIL
TOTAL DEPTH

PRODUCTION

1ST 24 HRS. NAT.
1ST 24 HRS. AFTER SHOT
GAS CU. FT.
DRY HOLE
ABANDONED

DATE	SCOUT
SEP 7 1955	L. J. Harris

FORM 513 REV. SUNRAY

County Butler Elev. 1408

Sec. 6 Twp. 23 Rge. 4E

Company Beaumont Pet.

Farm Name Hawk Heirs No. 2

TOPS	DEPTH	LOG	DATUM
Anh.			
Tp.			
H.			
Tr.			
Dg.			
Bl.			
L.	1902		494
K.C.			
B.K.C.	2273		865
Ce. Marm.	2335		927
C.	2462		1054
M. Chert	2465		1057
M.			
K.			
Mz.			
Mo.			
V.			
S.			
S.			
A			
R.			
P€.			
G.			
T.D.	2466		

Loc. in Sec. SW NE NW

Geol.

Contr. Co. tools

Pool Edmonds



Date Comm. 8-25-55 OCT 5 1955

10" @ 86/90 7" @ 2468/50 DD 2471

wtr. PB 2468 27/ 2465-68 frac HFW

D & A

Co. Lse. No. Sec. T. R.