


Map No. _____ Sec. 5 Twp. 23 R. 4
Well No. 1 Fawley Farm
Tidal Company

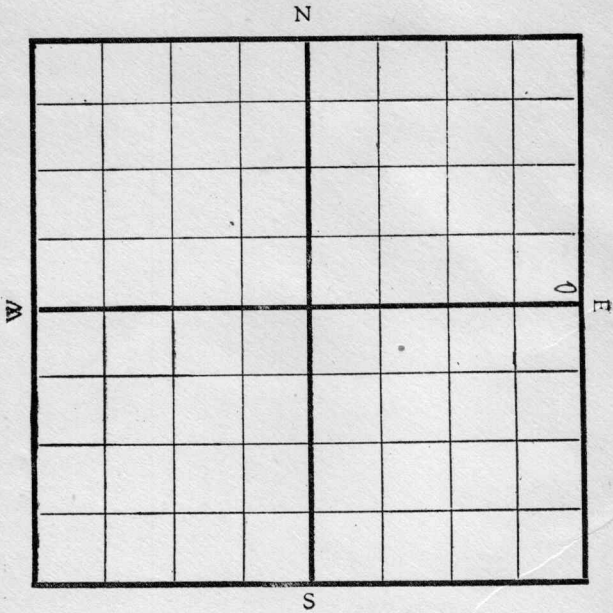

Location _____

Drilling Remarks:

RECORD

Cased _____ in. _____ ft.
Sand _____
Gas _____
Oil _____
Total Depth _____

Rig Up _____

Drilling Remarks:

PRODUCTION

1st 24 hrs. Nat. _____
1st 24 hrs. after shot _____
Gas _____ cu. ft.
Dry Hole _____
Abandoned _____

COMPLETED

Map No. _____ Sec. 5 Twp. 23 R. 4Well No. 1 Fawley FarmYidal Oil Company


Contractor

NE Quarter

Ft. from N. Line

200 Ft. from S. Line200 Ft. from E. Line

Ft. from W. Line

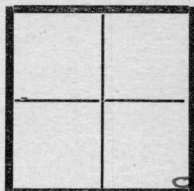1899
Date

REPORT

11/12	Rig up (702)
14	Rig
25	Rig up
12/2	Tools
9	Rigged up, Shut down
16	Rigged up & 25
22	Spudding
31	12 1/2 800'
1/6/20	1300'
14	Dril 1800'
19	fish 10" at 1800'
27	- - -
2/2	Dril 2075'
9	Dril 2250'
16	Dril 2490'
23	Sand 2490' - 93' Small show
3/1	Sand 2490 - 93' trying to shut off water
8	Sand 2490' - 93' shut down
15	2490' - 93' - 10 Bbl Oil
	5 ✓ water
	Pumps off in 6 hrs

Map No. K 14 Sec. 5 Twp. 23 R. 4Well No. 1 FawleyTidal Oil Company


Contractor

SECTION PLAT

Ft. from N. Line

200 Ft. from S. Line200 Ft. from E. Line

Ft. from W. Line

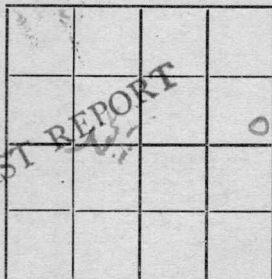

Location

Rig up ☒

Drilling and Remarks:

RECORD

Cased _____ in., _____ ft.

Sand _____

Gas _____

Oil _____

Total Depth _____

PRODUCTION

1st 24 hrs. Nat. _____

1st 24 hrs. after shot _____

Gas _____ Cu. Ft.

Dry Hole _____

Abandoned _____

Date

11/12 1919

Pyle

Scout

Map No. K 14 Sec. 5 Twp. 23 R. 4Well No. 1 FawleyTidal Oil Company

Contractor

SECTION PLAT

Ft. from N. Line

200 Ft. from S. Line200 Ft. from E. Line

Ft. from W. Line

COMPLETED

Location

Rig up

Drilling and Remarks:

10 bbls oil
5 bbls water
pumps off in
6 hours

RECORD

Cased _____ in., _____ ft.

Sand 2490 - 93

Gas _____

Oil _____

Total Depth _____

PRODUCTION

1st 24 hrs. Nat. _____

1st 24 hrs. after shot _____

Gas _____ Cu. Ft.

Dry Hole _____

Abandoned _____

Date

3/15 19120

Pyle

Scout

Butler
 K14 MAP No. KANSAS SEC. 5 TWP. 23S R. 4E

CONTRACTOR

SECTION PLAT

ABANDONED

_____ FT. FROM N. LINE
 _____ FT. FROM S. LINE
 _____ FT. FROM E. LINE
 _____ FT. FROM W. LINE

RECORD

LOCATION _____
 RIG UP _____
 DRILLING AND REMARKS:

CASED _____ IN., _____ FT.
 SAND _____
 GAS _____
 OIL _____
 TOTAL DEPTH 2492

PRODUCTION

1ST 24 HRS. NAT. _____
 1ST 24 HRS. AFTER SHOT _____
 GAS _____ CU. FT.
 DRY HOLE _____
 ABANDONED ☒

DATE

3/15 1920 SCOUT