


Map No. _____ Sec. 2 Twp. 26 R. 4Well No. 50 Paulson Farm _____Empire Company _____

NORTH

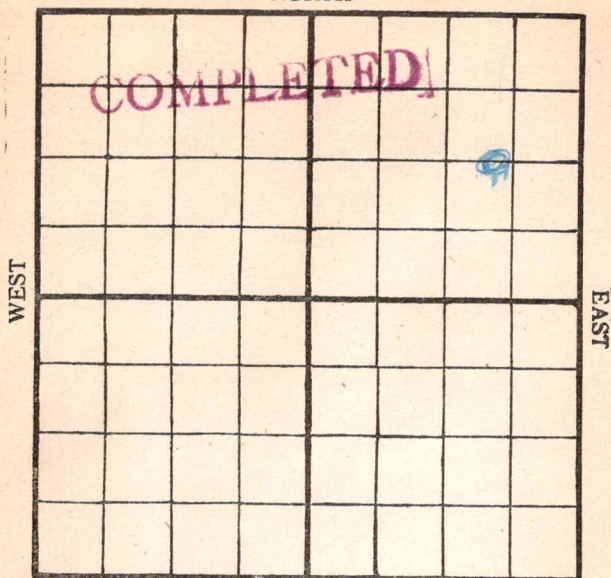

SOUTH

Location _____

Rig Up _____

Drilling Remarks:

Drilling Remarks:

500 Bales (Aug 2380-2403)Ep. 19 / 18

RECORD

Cased _____ in. _____ ft.

Sand _____

Gas _____

Oil _____

Total Depth _____

PRODUCTION

1st 24 hrs. Nat. _____

1st 24 hrs. after shot _____

Gas _____ cu. ft.


Dry Hole _____

Abandoned _____

Map No. K14 Sec. 2 Twp. 26 R. 4Well No. 50 Paulson FarmEngine Company

NORTH

WEST

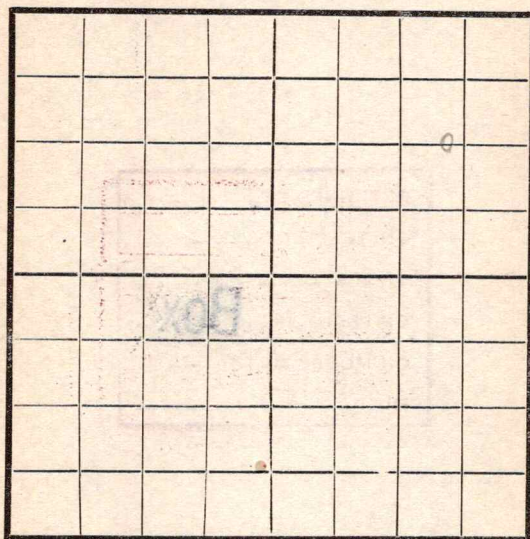

EAST

SOUTH

Location ✓Rig Up ✓

Drilling and remarks

1320 S of R.L.
810 W of R.L.

FIRST REPORT**RECORD**

Cased _____ in. _____ Ft.

Sand _____

Gas _____

Oil _____

Total Depth _____

PRODUCTION

1st 24 hrs. Nat. _____

1st 24 hrs. after shot _____

Gas _____ Cu. Ft.

Dry Hole _____

Abandoned _____

Date


3/13, 1918 Candey Scout

Map No. _____ Sec. 2 Twp. 26 R. 4

Well No. 50 Paulsboro Farm _____
Cummins Company

NORTH

WEST

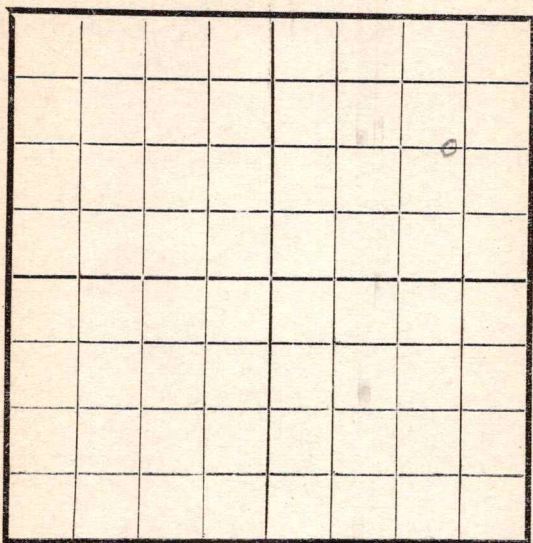

EAST

SOUTH

Location _____

Rig Up _____

Drilling and remarks

270

Marshall & McQuinn

El Dorado

SK

RECORD

Cased _____ in. _____ Ft

Sand _____

Gas _____

Oil _____

Total Depth _____

PRODUCTION

1st 24 hrs. Nat. _____

1st 24 hrs. after shot _____

Gas _____ Cu. Ft.

Dry Hole _____

Abandoned _____

Date

5/1

, 191

S. C. C. C.

Scout


Map No. _____ Sec. 2 Twp. 26 R. 4

Well No. 50 Paulson Farm

Engine Company

NORTH

WEST

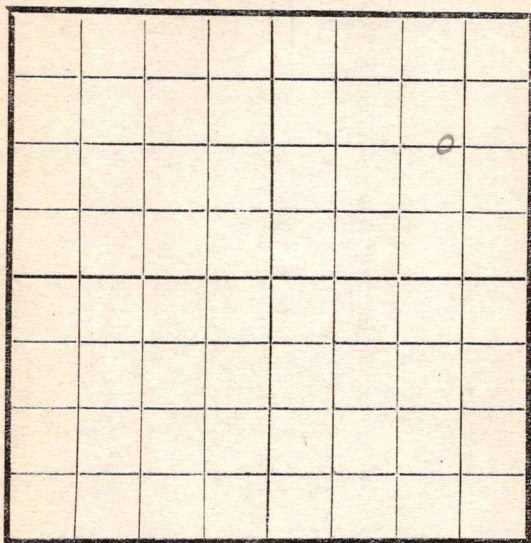

EAST

SOUTH

Location _____

Rig Up _____

Drilling and remarks

950

RECORD

Cased _____ in. _____ Ft.

Sand _____

Gas _____

Oil _____

Total Depth _____

PRODUCTION

1st 24 hrs. Nat. _____

1st 24 hrs. after shot _____

Gas _____ Cu. Ft.

Dry Hole _____

Abandoned _____

Date


5/8, 1918 Scout

Map No. _____ Sec. 2 Twp. 26 R. 4

Well No. 50 Pandora Farm
Evergreen Company

NORTH

WEST

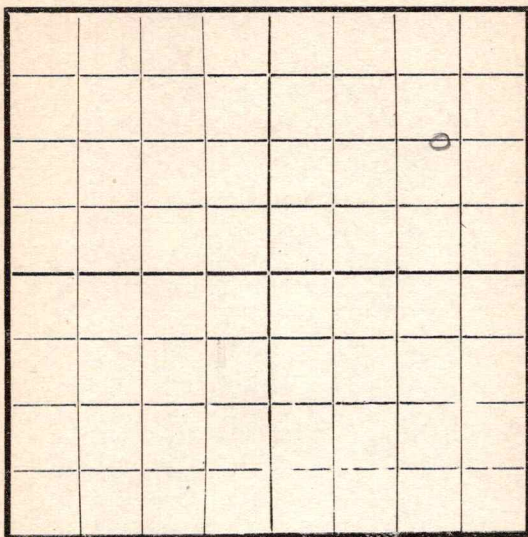

EAST

SOUTH

Location _____

Rig Up _____

Drilling and remarks

1380

RECORD

Cased _____ in. _____ Ft.

Sand _____

Gas _____

Oil _____

Total Depth _____

PRODUCTION

1st 24 hrs. Nat. _____

1st 24 hrs. after shot _____

Gas _____ Cu. Ft.

Dry Hole _____

Abandoned _____

Date

5/15


, 1918

Evergreen

Scout

Map No. _____ Sec. 2 Twp. 26 R. 4
 Well No. 50 Paulson Farm
Engine Company

NORTH

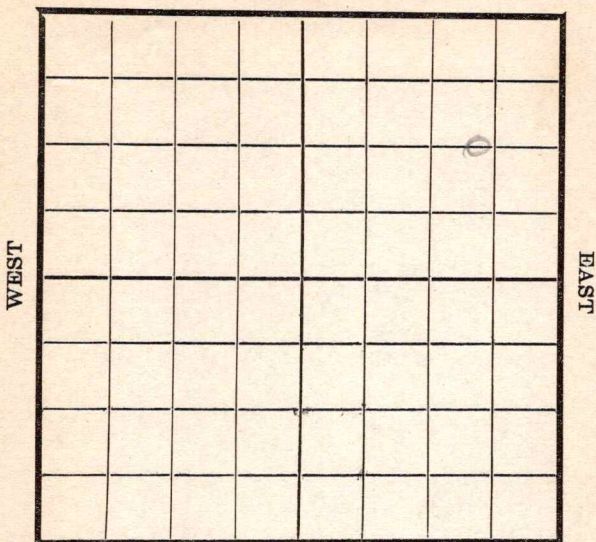

SOUTH

Location _____
 Rig Up _____
 Drilling and remarks

1450

RECORD

Cased _____ in. _____ Ft.
 Sand _____
 Gas _____
 Oil _____
 Total Depth _____

PRODUCTION

1st 24 hrs. Nat. _____
 1st 24 hrs. after shot _____
 Gas _____ Cu. Ft.
 Dry Hole _____
 Abandoned _____

Date

5/22, 1918 S. Condy Scout

Form 26—1M Books of 100 Sheets Each.


Map No. _____ Sec. 2 Twp. 26 R. 4

Well No. 50 Parlane Farm

Engine Company

NORTH

WEST

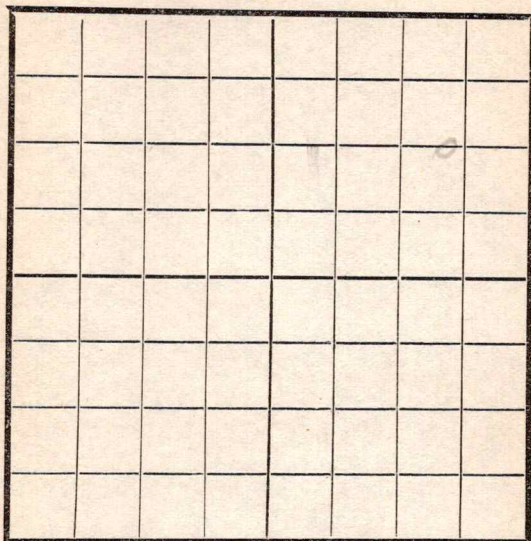

EAST

SOUTH

RECORD

Location _____

Cased _____ in. _____ Ft.

Rig Up _____

Sand _____

Drilling and remarks

Gas _____

Oil _____

Total Depth _____

PRODUCTION

1st 24 hrs. Nat. _____

1st 24 hrs. after shot _____

Gas _____ Cu. Ft.

Dry Hole _____

Abandoned _____

Date

5/29, 1918 C. Carley Scout

Map No. _____ Sec. 2 Twp. 26 R. 4Well No. 50 Paulson

_____ Company

_____ Contractor

NORTH

WEST

EAST

SOUTH

Location _____

Rig up _____

Drilling and Remarks:

2110

RECORD

Cased _____ in., _____ ft.

Sand _____

Gas _____

Oil _____

Total Depth _____

PRODUCTION

1st 24 hrs. Nat. _____

1st 24 hrs. after shot _____

Gas _____ Cu. Ft.

Dry Hole _____

Abandoned _____

Date

6/51918S. Cardiff


Scout

Map No. _____ Sec. 2 Twp. 26 R. 4Well No. 50 Paulson

_____ Company

_____ Contractor

NORTH

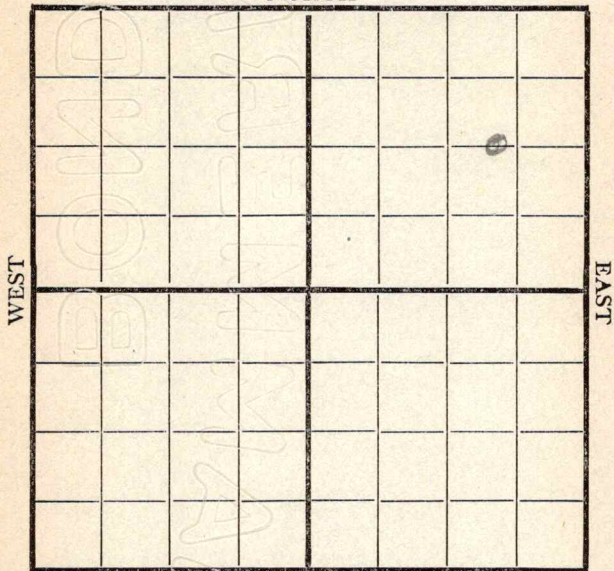

SOUTH

Location _____

Rig up _____

Drilling and Remarks:

Top sand
2380

RECORD

Cased _____ in., _____ ft.

Sand _____

Gas _____

Oil _____

Total Depth _____

PRODUCTION

1st 24 hrs. Nat. _____

1st 24 hrs. after shot _____


Gas _____ Cu. Ft.

Dry Hole _____

Abandoned _____

Date

6/19 191 *8* *Conley* Scout

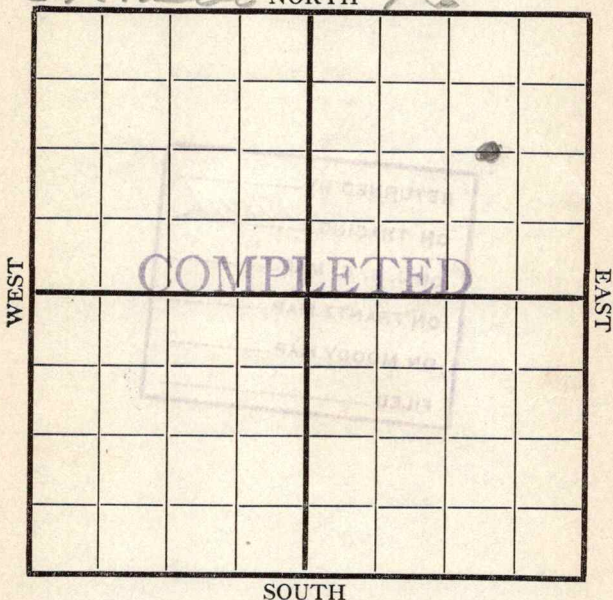Map No. K14 Sec. 2 Twp. 26 R. 4Well No. 50 PaulsonCompany EmpireContractor Murphy & Co. Inc.Edmond NORTH Mo

Location _____

Rig up _____

Drilling and Remarks:

Est at
500 Bbl

RECORD

Cased _____ in., _____ ft.

Sand 2380-2403

Gas _____

Oil _____

Total Depth _____

PRODUCTION

1st 24 hrs. Nat. _____

1st 24 hrs. after shot _____

Gas _____ Cu. Ft.

Dry Hole _____

Abandoned _____

Date

6/19 1918 W. A. Cardiff Scout