




[illegible]

Cased _____ in. _____ ft.
 Sand _____
 Gas _____
 Oil _____
 Total Depth _____

[illegible]


1st 24 hrs. Nat. _____
1st 24 hrs. after shot _____
Gas _____ cu. ft.
Dry Hole _____
Abandoned _____

Map No. Kansas Sec. 29 Twp. 23 R. 13^EWell No. 12 Bays FarmArkansas Fuel oil Company

_____ Ft. from N. Line

1892 Ft. from S. Line935 Ft. from E. Line

_____ Ft. from W. Line

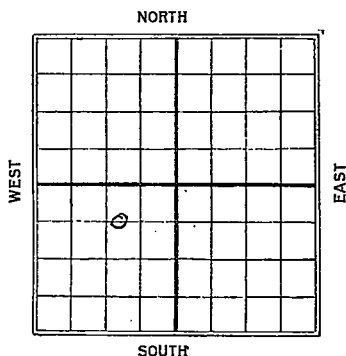

Date

1925

REPORT

4/10 Machine5/29 1625-1637 40 gts 15 Bbls

Map No. 17 Chndls Sec. 29 Twp. 23 R. 13^E
 Well No. 12 Buy
W. Chndls Fuel oil Co. Company

Contractor

FIRST REPORTS

SECTION PLAT

Ft. from N. Line

1892 Ft. from S. Line935 Ft. from E. Line

Ft. from W. Line

	o		

Location

Rig up

Drilling and Remarks:

Machine

RECORD

Cased _____ in., _____ ft.

Sand _____

Gas _____

Oil _____

Total Depth _____

PRODUCTION

1st 24 hrs. Nat. _____

1st 24 hrs. after shot _____

Gas _____ Cu. Ft.

Dry Hole _____

Abandoned _____

Date

APR 10 1925

192

Chs. L. Shewell
 Scout

Map No. 16460 Sec. 29 Twp. 23 R. 13Well No. 12 BlueMcKenzie Fuel Oil Co. Company

Contractor

COMPLETED

Ft. from N. Line

1892 Ft. from S. Line935 Ft. from E. Line

Ft. from W. Line

SECTION PLAT

	6		

Location

Rig up

Drilling and Remarks:

40/15 b/s

RECORD

Cased 1625-1637 in., ft.

Sand

Gas

Oil

Total Depth

PRODUCTION

1st 24 hrs. Nat.

1st 24 hrs. after shot

Gas Cu. Ft.

Dry Hole

Abandoned

Date

MAY 29 1925

192

CHAS. L. SHERWOOD

Scout