
DX 78-1 Butler KANSAS

Section 6 Township 23 Range 4E

Well No. #1Hawks "C"

Company K. T. Weidemann

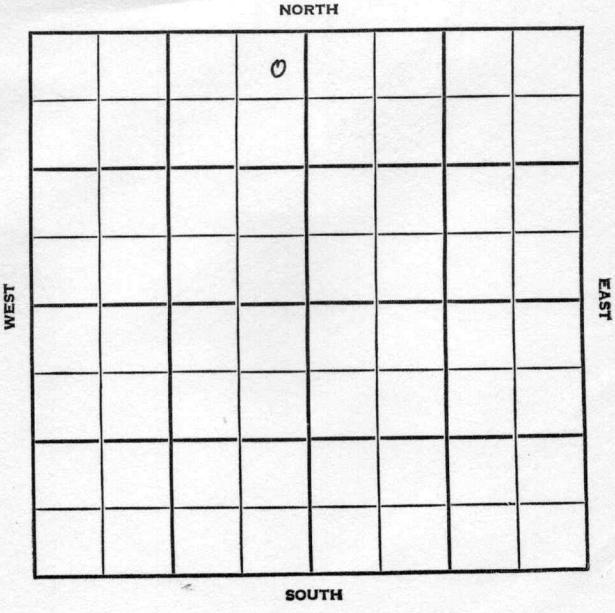

Butler KANSAS

SEC.	TWP.	R.
6	23	4E

WELL NO.

1 Hawks "C" FARM

COMPANY

K. T. Weidemann

CONTRACTOR

Edmonds Pool


330 Ft. from N. Line

Ft. from S. Line

330 Ft. from E. Line

Ft. from W. Line

NE NE NW

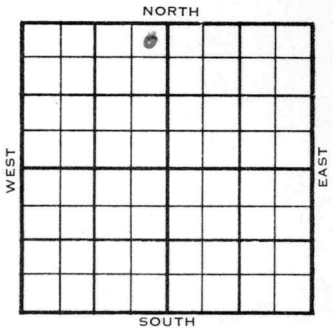

1954	ELEVATION -	REPORT
11/3		Spud 10-27-54 10 " @ 91' Drlg. 2190'
11/23		Spud 10-27-54 Oil Well TD 2462' 10" @ 91' Lans 1894' B KC 2262' Marm 2323' Miss 2450' TD 2453' 5" @ 2452' DD 2462' B/ 1 bo ¼ bw. 12hr. sd-oil-frac. Comp 10 bopd. 10 bw.

COMPLETED

DX-78

FORM 275 FOR SALE BY KANSAS BLUE PRINT CO.


County Butler State Kansas

Sec. 6 (Blk. Twp.) 23 (Sur. Rge.) 4E Map No.

Operator K. T. Weidemann

Well No. 1 Farm Hawks "C"

Elev. Location NE NE NW

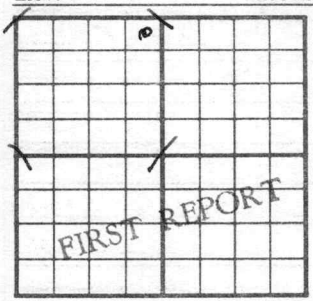

330 Ft. From N Line NW

330 Ft. From E Line Quarter

1st. Report NOV 3 1954

Completion

Remarks

Spudding Date 10-27-54

Drlg. Data Edmonds Pool

10" @ 91 drlg. 2190

FABEN GILSTRAP

FORM 275 FOR SALE BY KANSAS BLUE PRINT CO.


County Butler State Kansas

Sec. 6 (Blk. Twp.) 23 (Sur. Rge.) 4E Map No.

Operator K. T. Weidemann

Well No. 1 Farm Hawks "C"

Elev. Location NE NE NW

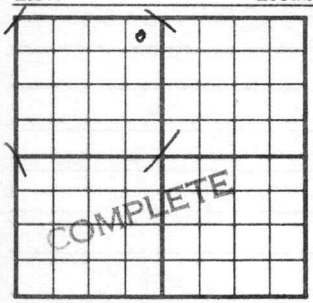

330 Ft. From N Line NW

330 Ft. From E Line Quarter

1st. Report

Completion NOV 23 1954

Remarks Edmonds Pool

Spudding Date 10-27-54

Drlg. Data Oil well TD 2462

10" @ 91 Lans. 1894 B KC 2262

Marm. 2323 Miss. 2450 TD 2453

5" @ 2452 DD 2462 B/ 1 bo $\frac{1}{4}$ bw

12 hr. sd-oil-frac Comp. 10 bopd 10 bw

FABEN GILSTRAP