


KANSAS

Section 29 Township 23 Range 13-EWell No. #15 BaysCompany W. A. Kent

(Virgil)

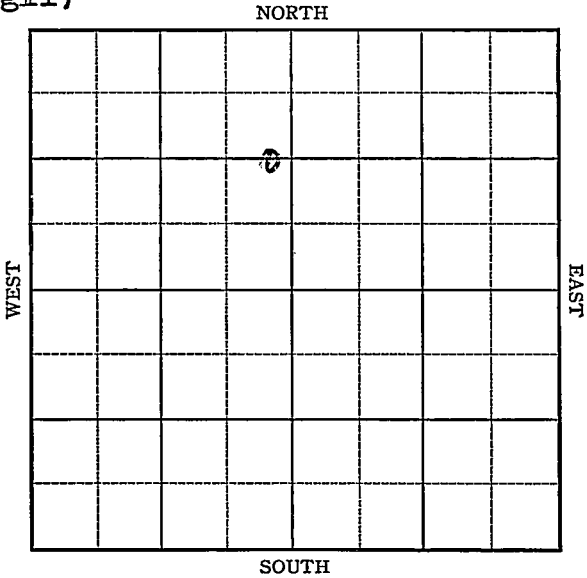

Sec. 29 Twp. 23 R. 13-E

Well No. 15 Bays Farm

W. A. Kent Company
(Virgil Pool) NORTH

1320 Ft. from N. Line


_____Ft. from S. Line

330 _____ Ft. from E. Line

Ft. from W. Line

C E L N W

NORTH

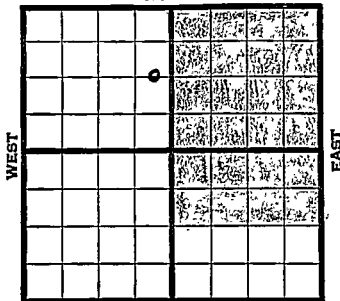

SOUTH

1941	REPORT
7/30	Machine
8/15	T.D. 340' - S.D.
8/21	Drlg. 500'
8/28	12" - 585' 10" - 861'
	Drlg. 910'
9/4	8" - 1316' Miss. ¹⁶⁵⁵ 1617 '
	Shut down.
9/11	Miss. 1655' 6" - 1650'
	T.D. 1675' 700' water & 500' oil
9/18	Shut down.
9/24	Miss. 1655'
	6" - 1650'
	T.D. 1675'
	Pump 5 oil.
	38. Gravity
	COMPLETED

Map No. 17 Sec. 29 Twp. 23 R. 13EWell No. 15 Bays _____

W. A. Kent _____ Company

Contractor


FIRST REPORTC E L NW
1320 Ft. from N. Line

_____ Ft. from S. Line

330 Ft. from E. Line

_____ Ft. from W. Line

VIRGIL POOL

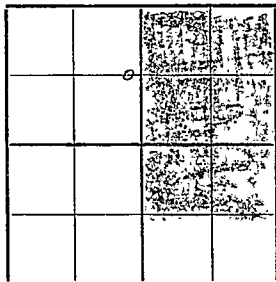SECTION PLAT

Location _____

Rig up _____

Drilling and Remarks:

Machine

RECORD

Cased _____ in., _____ ft.

Sand _____

Gas _____

Oil _____

Total Depth _____

PRODUCTION

1st 24 hrs. Nat. _____

1st 24 hrs. after shot _____

Gas _____ Cu. Ft.

Dry Hole _____

Abandoned _____

Date

JUL 3 0 1941 19S. J. LEWIS Scout

Map No. K-17 Sec. 29 Twp. 23 R. 13EWell No. 15 Bays __________W. A. Kent_____
Company_____COMPLETED_____
Contractor

C EL NW

1320Ft. from N. Line_____ Ft. from S. Line330Ft. from E. Line_____ Ft. from W. Line

SECTION PLAT

VIRGIL POOL

Location _____

Rig up _____

Drilling and Remarks:

*Nov 1655**6" @ 1650**Pump 5 oil**38th L*

RECORD

Cased _____ in., _____ ft.

Sand _____

Gas _____

Oil _____

Total Depth 1675

PRODUCTION

1st 24 hrs. Nat. _____

1st 24 hrs. after shot _____

Gas _____ Cu. Ft.

Dry Hole _____

Abandoned _____

Date

SEP 24 1941

19

S. J. LEWIS

Scout