


Map No. _____ Sec. 7 Twp. 23 R. 4Well No. 1 Eyestone FarmSabboth Stop Company

NORTH

WEST

EAST

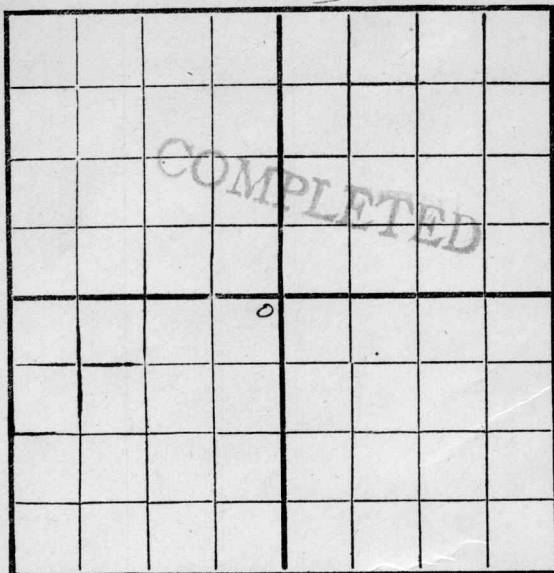

SOUTH

Location _____

Rig Up _____

Drilling Remarks:

Drilling Remarks:

RECORD

Cased _____ in. _____ ft.

Sand _____

Gas _____

Oil _____

Total Depth _____

PRODUCTION

1st 24 hrs. Nat. _____

1st 24 hrs. after shot _____

Gas _____ cu. ft.

Dry Hole _____

Abandoned _____

Map No. 10 Sec. 7 Twp. 23 R. 4Well No. 1. Eyestone FarmSabbath et al Company


Contractor

Sw. Quarter200 Ft. from N. Line

Ft. from S. Line

200 Ft. from E. Line

Ft. from W. Line

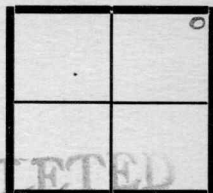

Date	REPORT
10/11	W. 650'
10/21	S. 650'
10/31	Dreg. 975'
11/4	SD 1000
12	10" parted at 1563
19	SD 1563
25	SD 1563'
12/2	W. water 1563
9	Shut down 1563'
16	SD 1563'
23	Shut down 1563'
31	✓ ✓ ✓
11/6/20	SD 1563'
14	SD 1563'
19	✓ ✓
27	SD 1640'
21/2	SD 1700'
9	Shut down 1700'
16	Dreg 1730
23	Dreg 1950'
31	A.W. 2000'
8	✓ ✓ (over)

3/15/20 - SD 2000

26 SD 2110'

29

2330

4/1, 2

24

Fry Lake 2402

29

Fry

5/3

Fresh Lake 2402

10

22

NT W. 2420


5/31

Dry Lake 2420'

Map No. K 14 Sec. 7 Twp. 23 R. 4Well No. 1 Eyestone
Dabbach et al Company

Contractor

SECTION PLAT

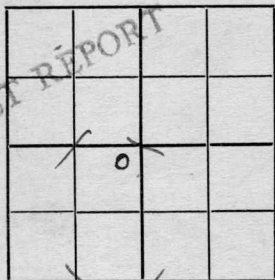200 Ft. from N. Line

Ft. from S. Line

200 Ft. from E. Line

Ft. from W. Line

Location

Rig up ☒

Drilling and Remarks:

RECORD

Cased _____ in., _____ ft.

Sand _____

Gas _____

Oil _____

Total Depth _____

PRODUCTION

1st 24 hrs. Nat. _____

1st 24 hrs. after shot _____

Gas _____ Cu. Ft.

Dry Hole _____

Abandoned _____

Date

9/15 191 9

Pyle

Scout

Map No. K14 Sec. 7 Twp. 23 R. 4Well No. 1 EyestoneSabbath chaf Company

Contractor

SECTION PLAT

200 Ft. from N. Line

Ft. from S. Line

200 Ft. from E. Line

Ft. from W. Line

	0		

Location

Rig up

Drilling and Remarks:

Rig'n up

RECORD

Cased _____ in., _____ ft.

Sand _____

Gas _____

Oil _____

Total Depth _____

PRODUCTION

1st 24 hrs. Nat. _____

1st 24 hrs. after shot _____

Gas _____ Cu. Ft.

Dry Hole _____

Abandoned _____

Date

9/23 1919

Pyle

Scout

Map No. K 14 Sec. 7 Twp. 23 R. 4Well No. 1 EyestoneSabbath et al Company

Contractor

SECTION PLAT

200 Ft. from N. Line

Ft. from S. Line

200 Ft. from E. Line

Ft. from W. Line

	0		

Location

Rig up

Drilling and Remarks:

Spud

RECORD

Cased _____ in., _____ ft.

Sand _____

Gas _____

Oil _____

Total Depth _____

PRODUCTION

1st 24 hrs. Nat. _____

1st 24 hrs. after shot _____

Gas _____ Cu. Ft.

Dry Hole _____

Abandoned _____

Date

9/30 1919

Pyle

Scout

Map No. K14 Sec. 7 Twp. 23 R. 4

Well No. 1 Eyestone

Rabbath et al Company

Contractor

SECTION PLAT

200 Ft. from N. Line

_____ Ft. from S. Line

200 Ft. from E. Line

_____ Ft. from W. Line

Location _____

Rig up _____

Drilling and Remarks:

650 S.D.

RECORD

Cased _____ in., _____ ft.

Sand _____

Gas _____

Oil _____

Total Depth _____

PRODUCTION

1st 24 hrs. Nat. _____

1st 24 hrs. after shot _____

Gas _____ Cu. Ft.

Dry Hole _____

Abandoned _____

Date

10/14 1919

Pyle

Scout

Map No. K 14 Sec. 7 Twp. 23 R. 4Well No. 1 EyestoneSubbath et al Company

Contractor

SECTION PLAT

200 Ft. from N. Line

Ft. from S. Line

200 Ft. from E. Line

Ft. from W. Line

	6		

Location

Rig up

Drilling and Remarks:

D. O. @
650'

RECORD

Cased _____ in., _____ ft.

Sand _____

Gas _____

Oil _____

Total Depth _____

PRODUCTION

1st 24 hrs. Nat. _____

1st 24 hrs. after shot _____

Gas _____ Cu. Ft.

Dry Hole _____

Abandoned _____

Date

10/21 1919

Pyle

Scout

MAP No. K14 SEC. 7 TWP. 23S R. 4E
WELL No. KANSAS & yes tone
Block Sat with et al COMPANY

CONTRACTOR


SECTION PLAT

_____ FT. FROM N. LINE

_____ FT. FROM S. LINE

_____ FT. FROM E. LINE

_____ FT. FROM W. LINE

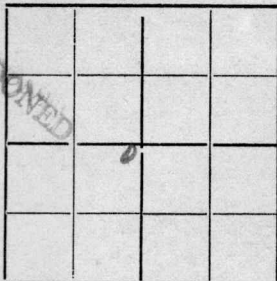

LOCATION _____

RIG UP _____

DRILLING AND REMARKS:

RECORD

CASED _____ IN. _____ FT.

SAND _____

GAS _____

OIL _____

TOTAL DEPTH 2420

PRODUCTION

1ST 24 HRS. NAT. _____

1ST 24 HRS. AFTER SHOT _____

GAS _____ Cu. Ft.

DRY HOLE ✓

ABANDONED _____

DATE

5/24 192 0 SCOUT

Map No. K14 Sec. 7 Twp. 23 R. 4Well No. 1 EyestoneSabbath et al Company

Contractor

SECTION PLAT

200 Ft. from N. Line

Ft. from S. Line

200 Ft. from E. Line

Ft. from W. Line

COMPLETED

Location

Rig up

Drilling and Remarks:

RECORD

Cased _____ in., _____ ft.

Sand _____

Gas _____

Oil _____

Total Depth _____

PRODUCTION

1st 24 hrs. Nat. _____

1st 24 hrs. after shot _____

Gas _____ Cu. Ft.

Dry Hole 2420

Abandoned _____

Date

5/31 1920

Pyle

Scout