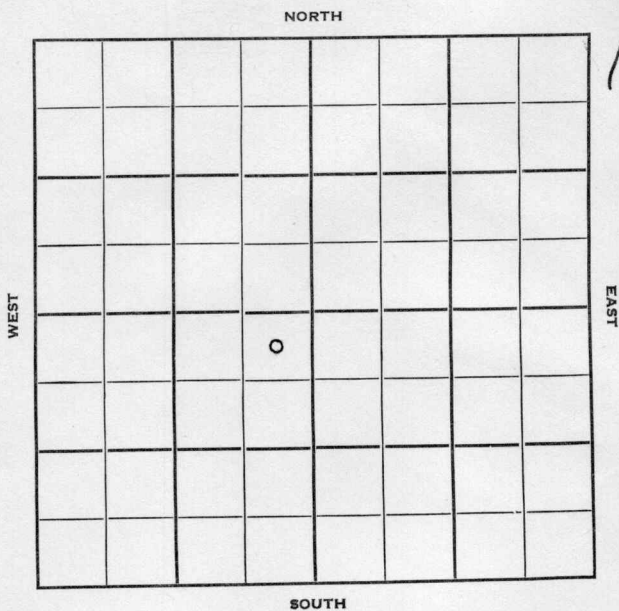


Section 31 Township 23 Range 5-EWell No. #1 GertarudeCompany Rex Morris

Butler

KANSAS

Sec. 31 Twp. 23 R. 5E

Well No. #1 Gerterude Farm

Rex Morris

Company

Contractor


330' Ft. from N. Line

Ft. from S. Line

330' Ft. from E. Line

Ft. from W. Line

NE NE SW

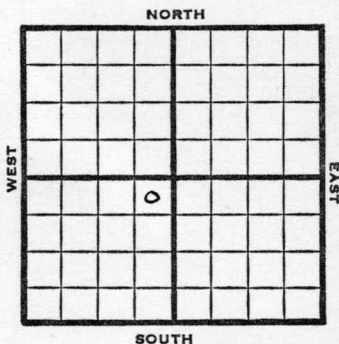

1950

Elev 1448

REPORT

5/31

Location

6/28

15 1/2" @ 190

13" @ 708

10" @ 1273

Lans 1805

sdv sh 2230

Miss 2458

7" @ 2457

TD 2467

Comp 30 bopd

Completed

COMPLETED

KC 2010

Cong 2448-58

Map No. _____ Sec. 31 Twp. 23 R. 5EWell No. 1 GerterudeRex Morris _____ Company_____
NE NE SW Contractor330 _____ Ft. from N. Line

_____ Ft. from S. Line

330 _____ Ft. from E. Line

_____ Ft. from W. Line

SECTION PLAT

	o		
FIRST		REPORT	

ButlerLocation X

Rig up _____

Drilling and Remarks:

RECORD

Cased _____ in., _____ ft.

Sand _____

Gas _____

Oil _____

Total Depth _____

PRODUCTION

1st 24 hrs. Nat. _____

1st 24 hrs. after shot _____

Gas _____ Cu. Ft.

Dry Hole _____

Abandoned _____


Date

MAY 31 1950 19 J E TYRA Scout

Kansas

Map No. _____ Sec. 31 Twp. 23 R. 5EWell No. 1 Gertrude_____
Rex & Morris Company_____
Contractor

NE NE SW

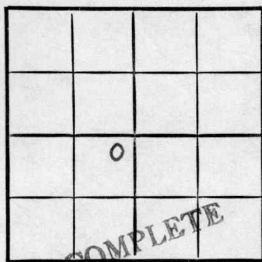E1. 1448
SECTION PLAT_____
330 Ft. from N. Line_____
Ft. from S. Line_____
330 Ft. from E. Line_____
Ft. from W. Line

Butler County

Location _____

Rig up _____

Drilling and Remarks:

15 $\frac{1}{2}$ " @ 190

13" @ 708

10" @ 1273

Lans. 1805

KC 2010

sdy. sh. 2230

Cong. 2448-58

RECORD

Cased _____ in., _____ ft.

Sand _____

Gas _____

Oil _____

Total Depth 2467

PRODUCTION

1st 24 hrs. Nat. _____

1st 24 hrs. after shot _____

Gas _____ Cu. Ft.

Dry Hole _____

Abandoned _____

Date

JUN 28 1950
19

J. E. TYRA Scout

Miss. 2458

Date: 7" © 2457

TD 2467

Comp. 30 bopd

1950 3

Scout Cards
Land Small Map
Land Wall Map
Tracings
France Map
Pierce Map
Misc.

PRODUCTION
Total
On
Base
Cost
RECORD



SECTION PLAT

Comptroller

Company

Map No.

Map No.

REUSE

How to use it