


KANSAS

Section 31 Township ~~25~~ 23 Range 5E

Well No. #2 Gertrude

Company Rex & Morris

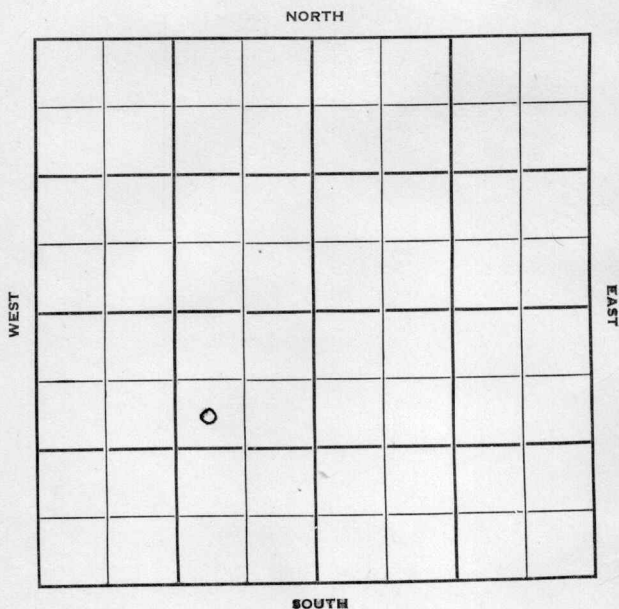

KANSAS

Butler

Sec. 31 Twp. 2523 R. 5-E ✓

Well No. #2 Gertrude Farm

Rex & Morris

Company

Contractor

Hazlett


990 Ft. from N. Line

Ft. from S. Line

990 Ft. from E. Line

Ft. from W. Line

SW NE SW

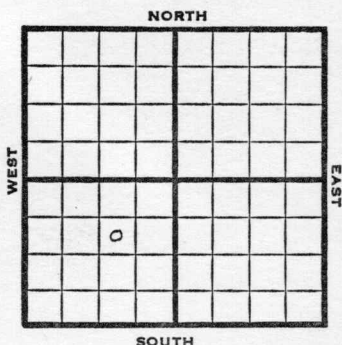

1950

Elev 1451

REPORT

7/26 Rig Up

8/23 15" @ 195

8" @ 1630

6" @ 1950

KC 2095

Miss 2458

5" @ 2459

TD 2471

Comp 40 bopd

Completed

Cong 3456

COMPLETED

Map No. _____ Sec. 31 Twp. 25 R. 5EWell No. 2 GertrudeRex & Morris

Company

Contractor

SW NE SW

SECTION PLAT

FIRST REPORT

990 Ft. from N. Line

_____ Ft. from S. Line

990 Ft. from E. Line

_____ Ft. from W. Line

Butler County

Location _____

Rig up X

Drilling and Remarks:

RECORD

Cased _____ in., _____ ft.

Sand _____

Gas _____

Oil _____

Total Depth _____

PRODUCTION

1st 24 hrs. Nat. _____

1st 24 hrs. after shot _____

Gas _____ Cu. Ft.

Dry Hole _____

Abandoned _____

Date

JUL 26 1950 19

J. E. TYRA

Scout

Kansas

Map No. _____ Sec. 31 Twp. 23 R. 5EWell No. 2 Gertrude_____
Rex & Morris Company_____
CORRECTION Contractor

SW NE SW


SECTION PLAT

990 Ft. from N. Line

_____ Ft. from S. Line

990 Ft. from E. Line

_____ Ft. from W. Line

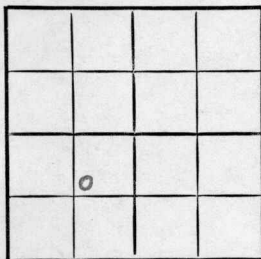

Butler County

Location _____

Rig up _____

Drilling and Remarks:

Reported

31-25-5E

RECORD

Cased _____ in., _____ ft.

Sand _____

Gas _____

Oil _____

Total Depth _____

PRODUCTION

1st 24 hrs. Nat. _____

1st 24 hrs. after shot _____


Gas _____ Cu. Ft.

Dry Hole _____

Abandoned _____

Date

AUG 2 1950 J. E. TYRA Scout

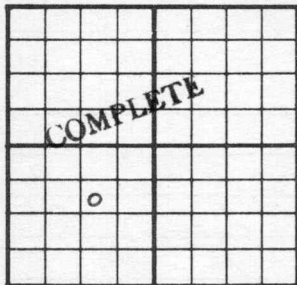County Butler State KansasSec. 31 (^{Blk.}
^{Twp.}) 23 (^{Sur.}
^{Rge.}) 5E Map No. _____Operator Rex & MorrisWell No. 2 Farm GertrudeElev. 1451 Location SW NE SW990 Ft. From N Line SW990 Ft. From E Line Quarter

1st. Report _____

Completion AUG 23 1950

Remarks _____

Hazlett Pool

Spudding Date _____

Drlg. Data Oil well TD 247115" @ 195 8" @ 1630 6" @ 1950KC 2095 Cong. 2456 Miss. 24585" @ 2459 TD 2471 Comp. 40 bopd

J. E. TYRA