
FORM 51 25M 8-50 WESTERN Butler KANSAS

Section 31 Township 23 Range 5E

Well No. #4 Gertrude

Company Rex & Morris

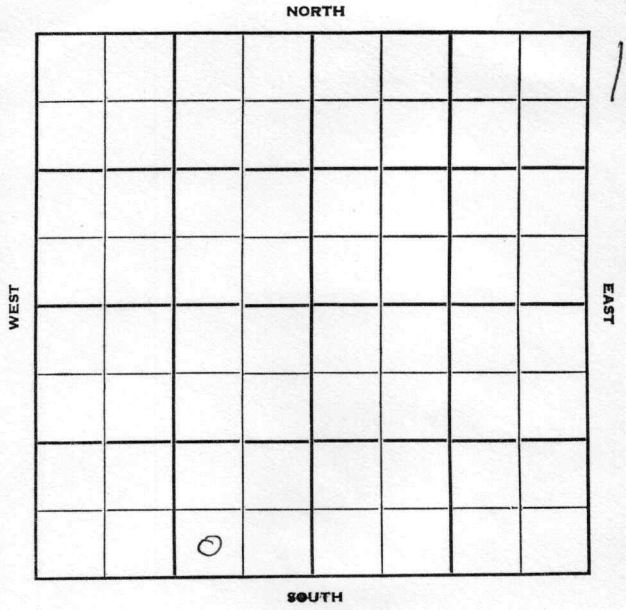

14

FORM 252-B
10M 10-50 PETROL

Butler KANSAS

Sec. 31 Twp. 23 R. 5 E

Well No. # 4 Gertrude Farm

Rex & Morris Company

Contractor


_____ Ft. from N. Line

330 Ft. from S. Line

990 Ft. from E. Line

_____ Ft. from W. Line

SW SE SW

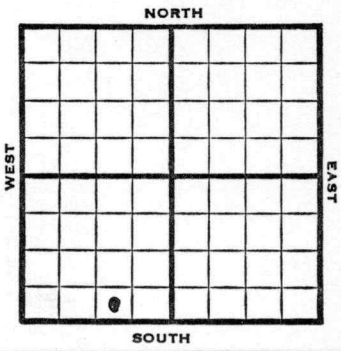

1952	Elev. 1449' REPORT
5/21	Location
6/18	Spud 6-7-52 D&A TD 2484 10" @ 130 Cong. 2438 Miss 2464 TD 2484 D&A ABANDONED

FORM 275 FOR SALE BY KANSAS BLUE PRINT CO.


County Bulter State Kansas

Sec. 31 (Blk. Twp.) 23 (Sur. Rge.) 5E Map No.

Operator Rex & Morris

Well No. 4 Farm Gertrude

Elev. Location SW SE SW

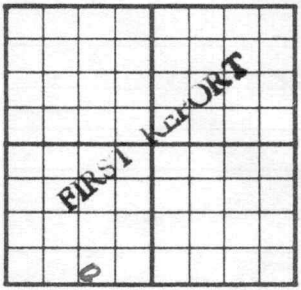

330 Ft. From S Line SW

990 Ft. From E Line Quarter

1st. Report MAY 21 1952

Completion

Remarks

Spudding Date

Drlg. Data

Location

J. G. McGEHEE

FORM 275 FOR SALE BY KANSAS BLUE PRINT CO.


County Butler State Kansas

Sec. 31 (Blk. Twp.) 23 (Sur. Rge.) 5E Map No.

Operator Rex & Morris

Well No. 4 Farm Gertrude

Elev. 1449 Location SW SE SW

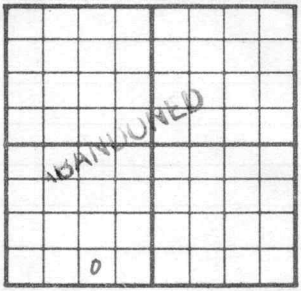

330 Ft. From S Line SW

990 Ft. From E Line Quarter

1st. Report

Completion JUN 18 1952

Remarks

Spudding Date 6-7-52

Drlg. Data D & A TD 2484

10" @ 130 Cong. 2438 Miss. 2464

TD 2484

D & A

J. G. McGEHEE