


Section 32 Township 23 Range 5EWell No. #3 Fannie Clearwater AmmeterCompany K. T. Weidemann

NORTH

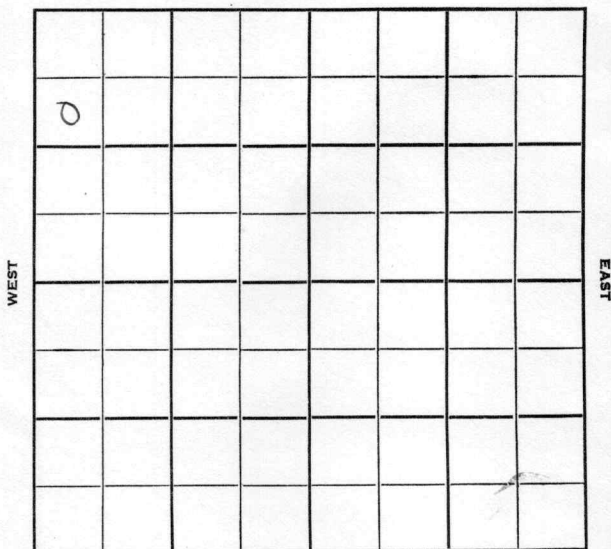

SOUTH

Butler

KANSAS



Sec. 32 Twp. 23 R. 5E

Well No. #3 Fannie Clearwater Farm

K. T. Weidemann

Company

Contractor


990' Ft. from N. Line

Ft. from S. Line

Ft. from E. Line

330' Ft. from W. Line

SW NW NW

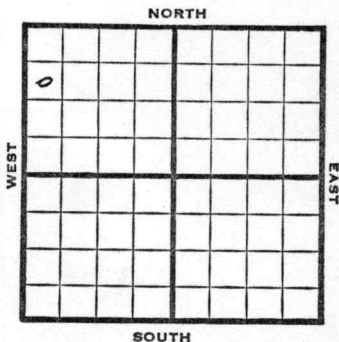

1950

Elev. 1476'

REPORT

11/29

Spud 11-25-50

8" @ 130'

Drlg. 400'

1951

1/24

Spud 11-25-50

8" @ 130

Miss 2438

5" @ 2441

TD 2464

FU 310' oil

Cong 2426-64½ TD

Comp 20 bopd

Completed

COMPLETED

County Butler State KansasSec. 32 (Blk.
Twp.) 23 (Sur.
Rge.) 5E Map No.Operator K. T. WeidemannWell No. 3 Farm Fannie ClearwaterElev. 1476 Location SW NW NW

0							

990 Ft. From N Line NW330 Ft. From W Line Quarter1st. Report NOV 29 1950

Completion _____


Remarks _____

Spudding Date 11-25-50

Drlg. Data _____

8" @ 130 drlg. 400

County Butler State Kansas
 Sec. 32 (Blk. 2 Twp. 3) (Sur. 5E Rge.) Map No.
 Operator K. T. Weidemann
 Well No. 3 Farm Fannie Clearwater
 Elev. 1476 Location SW NW NW

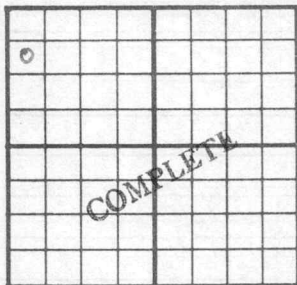

990 Ft. From N Line NW
330 Ft. From W Line Quarter

Ist. Report

Completion JAN 24 1951

Remarks

Spudding Date 11-25-50

Drlg. Data Oil well TD 2464

8" @ 130 Miss. 2438 5" @ 2441 TD 2464

FU 310' oil Cong. 2426-64½ TD

Comp. 20 bopd

*Correct farm
name*

J. E. TYRA