

Section 32 Township 23 Range 5 EWell No. #4 Fannie AmmeterCompany K. T. Weidemann

NORTH

0							

WEST

EAST

SOUTH

Butler KANSAS

Sec. 32 Twp. 23 R. 5E ✓

Well No. #4 Fannie Ammeter Farm

K.T. Weidemann Company

Weidemann - Contr. Contractor


 Ft. from N. Line

990' Ft. from S. Line

 Ft. from E. Line

330' Ft. from W. Line

NW SW NW

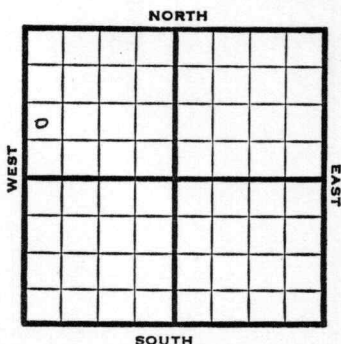

1951

Elev. 1473'

REPORT

1/17

Spud 1-15-51

Drlg.

3/7

Spud 1-15-51

Oil well TD 2468'

8" @ 125

KC 2070

B KC 2230

Chat 2443

TD 2445'

5" @ 2445"

DD 2468

Hydrafrac

Comp. 25 bopd 5 bwpd

COMPLETED

County Butler State KansasSec. 32 (Blk. 23 (Sur. 5E Map No.)
(Twp.) (Rge.)Operator K. T. WeidemannWell No. 4 Farm Fannie AmmeterElev. Location NW SW NW

0									

990 Ft. From S Line NW330 Ft. From W Line Quarter1st. Report JAN 17 1951Completion Remarks Weidemann - Contr.Spudding Date 1-15-51Drlg. Data drlg.

County Butler State KansasSec. 32 (Blk.
Twp.) 23 (Sur.
Rge.) 5E Map No. _____Operator K. T. WeidemannWell No. 4 Farm Fannie AmmeterElev. 1473 Location NW SW NW

0							

COMPLETE

990 Ft. From S Line NW330 Ft. From W Line Quarter

1st. Report _____

Completion MAR 7 1951

Remarks _____

Weidemann - Contr.Spudding Date 1-15-51Drlg. Data Oil well TD 24688" @ 125 KC 2070 B KC 2230Chat 2443 TD 2445 5" @ 2445 DD 2468Hydrofrac Comp. 25 bopd 5 bwpd

J. E. TYRA