


Map No. R14 Sec. 7 Twp. 23 R. 4

Well No. 4 Cyestone Farm

Lypsy Etap Company

NORTH

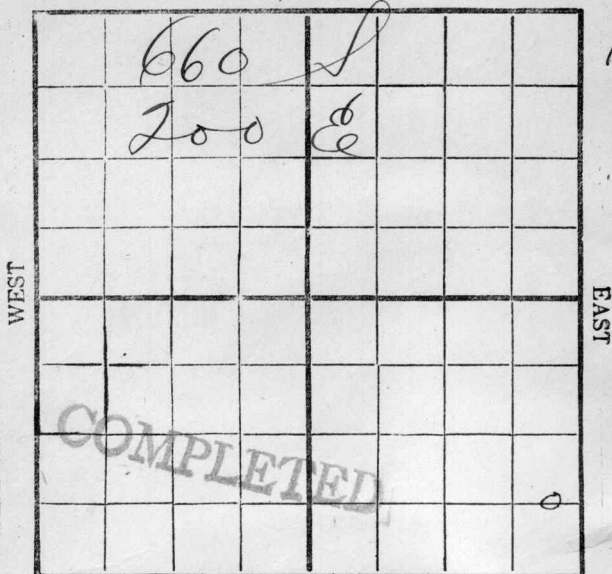

SOUTH

Location -----

Rig Up -----

Drilling Remarks:

Drilling Remarks:

RECORD

PRODUCTION

Cased ----- in. ----- ft.

1st 24 hrs. Nat. -----

Sand -----

1st 24 hrs. after shot -----

Gas -----

Gas ----- cu. ft.

Oil -----

Dry Hole -----

Total Depth -----

Abandoned -----


Map No. _____ Sec. 7 Twp. 23 R. 4Well No. 4 Exustone Farm _____Gypsy Oil Co. Company _____Contractor J.E. _____

Quarter _____

_____ Ft. from N. Lice

660 Ft. from S. Line700 Ft. from E. Line

_____ Ft. from W. Line

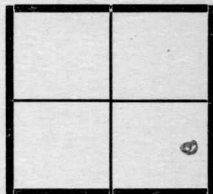

Date _____ REPORT

1919	
19	Rig.
19/21	Dreg 400'
10/31	Dreg. 720'
11/4	RD 960
12	RD 1260
19	RD 1260
25	Shutdown 1260'
12/2	RD 1260
9	Shutdown 1260'
16	RD 1260'
22	fishing tools 1295'
31	✓ ✓ ✓
1/6/20	14 45'
14	RD 1695'
19	RD 1695'
27	RD 1790'
2/2	RD 1950'
9	Dreg. 2190'
16	Show oil 2410' - 13'
23	Sand 2410' - 13' - 10 BHP

Map No. K 14 Sec. 7 Twp. 23 R. 4
Well No. 4 Eyestone
Typany Oil et al Company
Contractor

SECTION PLAT

_____ Ft. from N. Line
1660 Ft. from S. Line
200 Ft. from E. Line
_____ Ft. from W. Line

Location _____
Rig up ☒
Drilling and Remarks:

RECORD

Cased _____ in., _____ ft.
Sand _____
Gas _____
Oil _____
Total Depth _____

PRODUCTION

1st 24 hrs. Nat. _____
1st 24 hrs. after shot _____
Gas _____ Cu. Ft.
Dry Hole _____
Abandoned _____

Date 9/9 1919 Pyle Scout

Map No. K14 Sec. 7 Twp. 23 R. 4Well No. 4 EyestoneLyssey et al Company

Contractor

SECTION PLAT

			Q

Ft. from N. Line

660 Ft. from S. Line200 Ft. from E. Line

Ft. from W. Line

RECORD

Location -----

Cased ----- in., ----- ft.

Rig up -----

Sand -----

Drilling and Remarks:

Gas -----

Oil -----

Total Depth -----

PRODUCTION

1st 24 hrs. Nat. -----

1st 24 hrs. after shot -----

Gas ----- Cu. Ft.

Dry Hole -----

Abandoned -----

Date

9/15 191 9

Pyle

Scout

Map No. 1514 Sec. 7 Twp. 23 R. 4Well No. 4 EyestonePyle Oil and Gas Company

Contractor

SECTION PLAT

Ft. from N. Line

660 Ft. from S. Line200 Ft. from E. Line

Ft. from W. Line

			0

Location

Rig up

Drilling and Remarks:

Rig'n up

RECORD

Cased _____ in., _____ ft.

Sand _____

Gas _____

Oil _____

Total Depth _____

PRODUCTION

1st 24 hrs. Nat. _____

1st 24 hrs. after shot _____

Gas _____ Cu. Ft.

Dry Hole _____

Abandoned _____

Date

9/23 1919

Pyle

Scout

Map No. K14 Sec. 7 Twp. 23 R. 4Well No. 4 EyestoneSydney Oil et al Company

Contractor

SECTION PLAT

Ft. from N. Line

660 Ft. from S. Line200 Ft. from E. Line

Ft. from W. Line

Location

Rig up

Drilling and Remarks:

Rig inup

RECORD

Cased _____ in., _____ ft.

Sand _____

Gas _____

Oil _____

Total Depth _____

PRODUCTION

1st 24 hrs. Nat. _____

1st 24 hrs. after shot _____

Gas _____ Cu. Ft.

Dry Hole _____

Abandoned _____

Date

9/30 1919Pyle

Scout

Map No. K 14 Sec. 7 Twp. 23 R. 4
Well No. 4 Eyestone
Typosy Oil Company
Contractor

SECTION PLAT

_____Ft. from N. Line
660 Ft. from S. Line
200 Ft. from E. Line
_____Ft. from W. Line

			o

Location _____
Rig up _____
Drilling and Remarks:

Rign up,

RECORD

Cased _____ in., _____ ft.
Sand _____
Gas _____
Oil _____
Total Depth _____

PRODUCTION

1st 24 hrs. Nat. _____
1st 24 hrs. after shot _____
Gas _____ Cu. Ft.
Dry Hole _____
Abandoned _____

Date 10/14 1919 Pyle Scout

Map No. K14 Sec. 7 Twp. 23 R. 4Well No. 4 EyestoneBy pay et al Company

Contractor

SECTION PLAT

-----Ft. from N. Line

660 Ft. from S. Line200 Ft. from E. Line

-----Ft. from W. Line

			0

Location -----

Rig up -----

Drilling and Remarks:

RECORD

Cased ----- in., ----- ft.

Sand -----

Gas -----

Oil -----

Total Depth -----

PRODUCTION

1st 24 hrs. Nat. -----

1st 24 hrs. after shot -----

Gas ----- Cu. Ft.

Dry Hole -----

Abandoned -----

Date

10/21 1919 Pyle Scout

Map No. K14 Sec. 7 Twp. 23 R. 4Well No. 4 EyestoneTyler Oil Company

Contractor

SECTION PLAT

Ft. from N. Line

660 Ft. from S. Line200 Ft. from E. Line

Ft. from W. Line



Location

Rig up

Drilling and Remarks:

RECORD

Cased _____ in., _____ ft.

Sand 2410-13

Gas _____

Oil _____

Total Depth _____

PRODUCTION

1st 24 hrs. Nat. 10 bbls

1st 24 hrs. after shot _____

Gas _____ Cu. Ft.

Dry Hole _____

Abandoned _____

Date

Pyle

2/23 1920

Scout