
Form 51 5M 8-24 16567

Map No. Kans Sec. 31 Twp. 23 R. 5

Well No. 3 Wilson Farm

Phillips Pet. Company

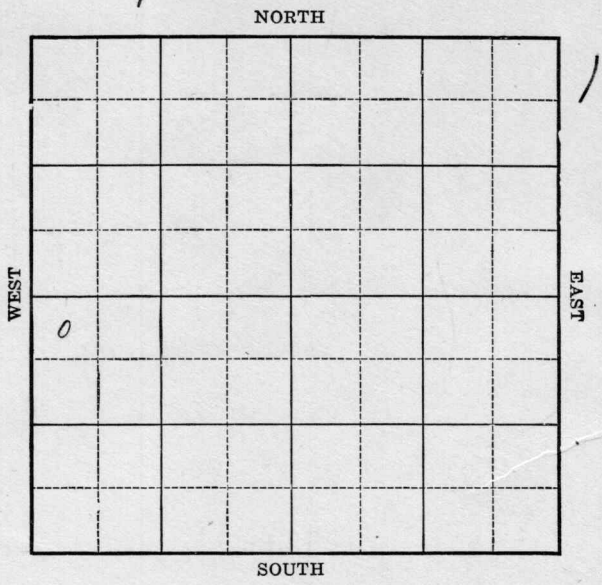

Location	Rig Up
Drilling Remarks	Drilling Remarks
RECORD	PRODUCTION
Cased in. ft.	1st 24 hrs. Nat.
Sand	1st. 24 hrs. after shot
Gas	Gas cu. ft.
Oil	Dry Hole
Total Depth	Abandoned

Form 252A 5M 8-24 16529

Map No. Kansas Sec. 31 Twp. 23 R 5

Well No. 3 Wilson Farm


Phillips Pet Company

330 Ft. from N. Line

Ft. from S. Line

Ft. from E. Line

330 Ft. from W. Line

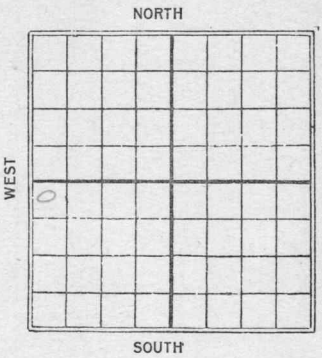

Date 1925	REPORT
3/24	R.O.G.
5/15	Top chat 2483, water, T.D. 2488

Form 26—1M Bks.—3-23—11959.

Map No. 14 KANSAS Sec. 31 Twp. 23 R. 5


Well No. 3 Wilson

Phillips Pet Company

Contractor

FIRST REPORT

SECTION PLAT

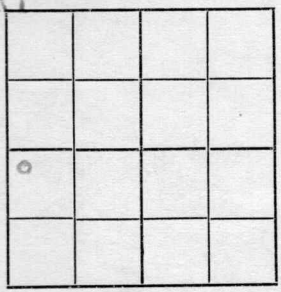

330 Ft. from N. Line

Ft. from S. Line

Ft. from E. Line

330 Ft. from W. Line

Location

Rig up

Drilling and Remarks:

R.a, Is.

RECORD

Cased in., ft.

Sand

Gas

Oil

Total Depth

PRODUCTION

1st 24 hrs. Nat.

1st 24 hrs. after shot

Gas Cu. Ft.

Dry Hole

Abandoned

Date

3/24 1925

M. A. BENEAR Scout

Form 26—1M Bks.—3-23—11959.

Map No. 17 Kinder Sec. 31 Twp. 23 R. 5

Well No. 3 Wilson

Phillips Pet Co. Company

Contractor

COMPLETED

330 Ft. from N. Line


Ft. from S. Line

Ft. from E. Line

330 Ft. from W. Line

ABANDONED

SECTION PLAT

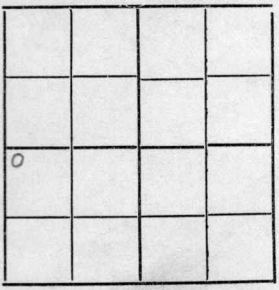

Location

Rig up

Drilling and Remarks:

Top Chat 2483'
Water.

RECORD

Cased in., ft.

Sand

Gas

Oil

Total Depth 2488

PRODUCTION

1st 24 hrs. Nat.

1st 24 hrs. after shot

Gas Cu. Ft.

Dry Hole ✓

Abandoned

Date MAY 15 1925
APR 24 1925

CHAS. L. SHERWOOD

192 Scout