

KARLS

Butler

Section 32 Township 23 Range 5
~~4E~~

Well No. 1 Ammeder *(Ammeter)*

Company K.T. Weidemann

Misc.
NORTH

WEST

0							

EAST

SOUTH

Butler KANSAS
23 R. 58 4E

Sec. 32 Twp. _____

Well No. #1 Ammedor _____ Farm _____

K.T.Weidemann _____ Company

Miscellaneous (Weidemann, Cont.)

_____ Ft. from N. Line

330'


_____ Ft. from S. Line

_____ Ft. from E. Line

330'

_____ Ft. from W. Line

SW NW

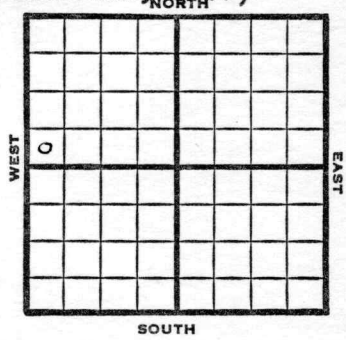

1842'

1949

Elev. ~~1482~~ DF REPORT

9/21 Spud
9/28 "
10/5 Drlg 1410'
10/12 Miss 2453-59'
TD 2459'
5"@ 2453'
10/19 TD 2482'
10/26 Drlg. 2491'
11/1 TD 2648 PB
11/9 TD 2648'
Miss 2453'
Aband.

ABANDONED

Map No. _____ Sec. 32 Twp. 23 R. 4E

Well No. 1 Ammeder

K. T. Weidemann Company

Weidemann Contractor

SW NW

FIRST REPORT
SECTION PLAT

Ft. from N. Line


330

Ft. from S. Line

Ft. from E. Line

330

Ft. from W. Line

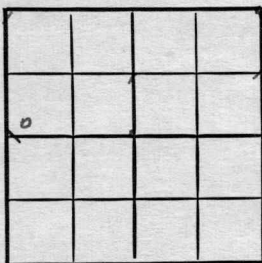

Butler County

Location _____

Rig up _____

Drilling and Remarks:

Spud

RECORD

Cased _____ in., _____ ft.

Sand _____

Gas _____

Oil _____

Total Depth _____

PRODUCTION

1st 24 hrs. Nat. _____

1st 24 hrs. after shot _____

Gas _____ Cu. Ft.

Dry Hole _____

Abandoned _____

Date

SEP 21 1949

19

S. J. LEWIS

Scout

Map No. _____ Sec. 32 Twp. 23 R. 5E

Well No. 1 Ammeter

K. T. Weidemann

Company

CORRECTION

Contractor

SW NW

SECTION PLAT

_____ Ft. from N. Line

330 Ft. from S. Line

_____ Ft. from E. Line

330 Ft. from W. Line

Butler County

Location _____

Rig up _____

Drilling and Remarks:

Reported

32-23-4E

RECORD

Cased _____ in., _____ ft.

Sand _____

Gas _____

Oil _____

Total Depth _____

PRODUCTION

1st 24 hrs. Nat. _____

1st 24 hrs. after shot _____

Gas _____ Cu. Ft.

Dry Hole _____

Abandoned _____

Date

SEP 28 1949 19

S. J. LEWIS

Scout

Kansas

Map No. _____ Sec. 32 Twp. 23 R. 5EWell No. 1 Ammeter

K. T. Weidemann _____ Company

ABANDONED _____ Contractor

SW NW

E. 1842
SECTION PLAT

o			

_____ Ft. from N. Line

330 _____ Ft. from S. Line

_____ Ft. from E. Line

330 _____ Ft. from W. Line

Butler County

Location _____

Rig up _____

Drilling and Remarks:

Miss 2452

RECORD

Cased _____ in., _____ ft.

Sand _____

Gas _____

Oil _____

Total Depth 2648

PRODUCTION

1st 24 hrs. Nat. _____

1st 24 hrs. after shot _____

Gas _____ Cu. Ft.

Dry Hole _____

Abandoned _____

Date

NOV 9. 1949

19

S. J. LEWIS

Scout


please check spot

1st report shows in

new Quarter

advise

Sam

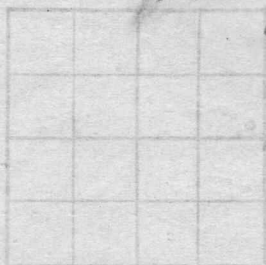

RECORD

Cased

Sand

Gas

Oil

Total Depth

Location

Rig up

Drilling and Remarks

NOV 21 1949

Scout Cards

Land Small Map

Land Wall Map

Tracings

France Map

Pierce Map

Misc.

Edith

G