

Butler

KANSAS

32

23


5E

SECTION _____ TOWNSHIP _____ RANGE _____

WELL NO. #5 Fannie Ammeter

COMPANY Beaumont

NORTH

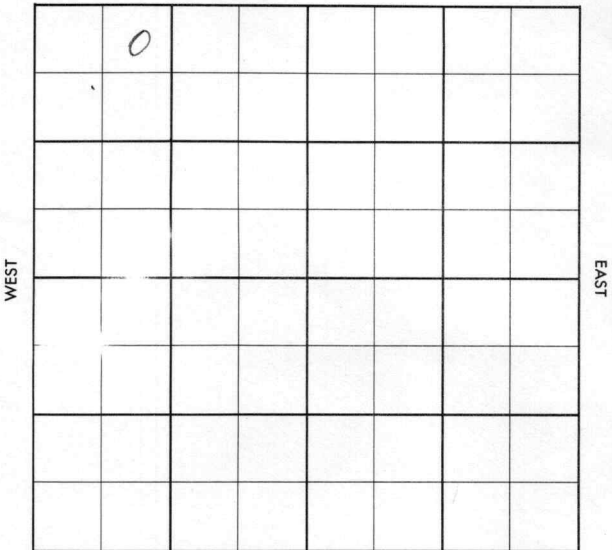

SOUTH

Butler

KANSAS

SEC.

32

TWP.

23

R.

5E

WELL NO.

#5 Fannie Ammeter

FARM

COMPANY

Beaumont

CONTRACTOR

Co Tools
Hazlett

____ FT. FROM N. LINE

____ FT. FROM S. LINE

____ FT. FROM E. LINE

____ FT. FROM W. LINE

		NORTH					
	0						
		SOUTH					

NE NW NW

1956

ELEVATION

1475 RB

REPORT

9-12

Comm 9-6-56
8" @ 101 w/100
Dr1g 2206


County Butler Elev. 1475 RB
 Sec. 32 Twp. 23 Rge. 5E
 Company Beaumont
 Farm Name Fannie Ammeter No. 5

TOPS	DEPTH	LOG	DATUM	Loc. in Sec.
Anh.				NE NW NW
Tr.				
H.				
Tr.				
Dg.				
Bl.				
L.				Geol.
K.C.				Contr.
B.K.C.				Co. Tools
Ce.				Pool
C.				Hazlett
M.				
M.				
K.				
Mz.				
Mq.				
V.				
S.				
S.				
A.				
R.				
PE.				
G.				
T.D.				

SEP 12 '56
 FIRST REPORT

Date Comm. 9/6/56
8" @ 101 w/100, Drlg. 2206

SEP 11 1956
 1034 AM

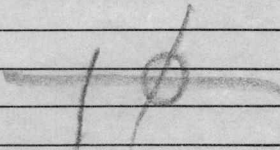

1476 DF

County Butler Elev 1475 RE
 Sec. 32 Twp. 23 Rge. 5E
 Company Beaumont
 Farm Name Fannie Ammeter No. 5

TOPS	DEPTH	LOG	DATUM	Loc. in Sec.
Anh.				NE NW NW
TP.				
H.				
Tr.				
Dg.				
Bl.				
L.				Geol.
K.C.	2068			Contr.
B.K.C.	2226			Co. Tools
Ce.				Pool
E. <u>Marm</u>	2293			Hazlett
M. <u>ce</u>	2409			
M. <u>cg sdy</u>	2424			
K. <u>M. chert</u>	2438			
Mz.				
Mo.				
V.				
S.				
S.				
A.				
R.				
PE.				
G.				
TD	2440			

Date Comm. 9/6/56

8" @ 101 w/100, Drlg. 2206

SEP 10 '56

7" 2440/ SEP 26 '56 DD 2449 1/2 TD

FU 150' oil no/w 12 hrs Frac

OCT 3 '56

P. 15 Bopd no/w