


Section 32 Township 23 Range 5-E

Well No. #2 Fannie Clearwater

Company K. T. Waideman

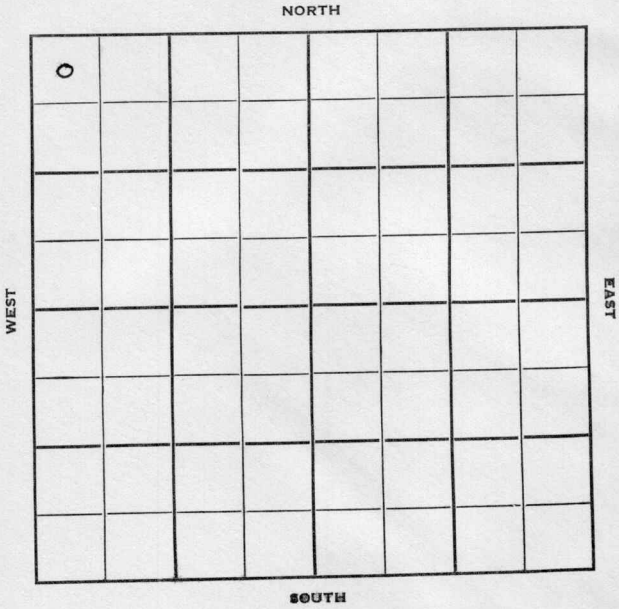

Butler KANSAS

32

23

5E

Sec. _____ Twp. _____ R. _____

Well No. #2 Fannie Clearwater Farm

W. T. Weideman Company

Contractor

Miscellaneous

330'

Ft. from N. Line


Ft. from S. Line

Ft. from E. Line

330'

Ft. from W. Line

NW NW NW

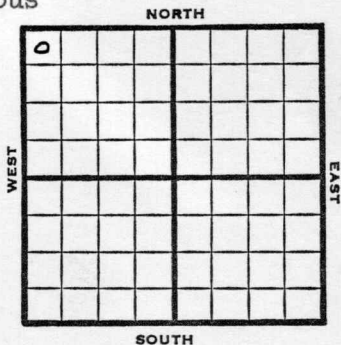

1950

Elev 1469

REPORT

5/10

Rig up

6/28

8 5/8" @ 169

Chert 2439-41

5" @ 2441

TD 2482

S/8 bo 8 bwph

42/2463-72

1000 acid

Comp 15 bopd

Completed

COMPLETED

Map No. _____ Sec. 32 Twp. 23 R. 5EWell No. 2 Fannie Clearwater_____K. T. Weideman_____
Company_____
Contractor

NW NW NW

SECTION PLAT

330 Ft. from N. Line_____
Ft. from S. Line_____
Ft. from E. Line330 Ft. from W. LineButler

Location _____

Rig up X

Drilling and Remarks:

RECORD

Cased _____ in., _____ ft.

Sand _____

Gas _____

Oil _____

Total Depth _____

PRODUCTION

1st 24 hrs. Nat. _____

1st 24 hrs. after shot _____

Gas _____ Cu. Ft.

Dry Hole _____

Abandoned _____

Date

MAY 10 1950

19

J. E. TYRA Scout

Kansas

Map No. _____ Sec. 32 Twp. 23 R. 5EWell No. 2 Fannie Clearwater_____ K. T. Weidemann _____ Company


_____ Contractor

NWNW NW

E1. 1469
SECTION PLAT330 Ft. from N. Line

_____ Ft. from S. Line

_____ Ft. from E. Line

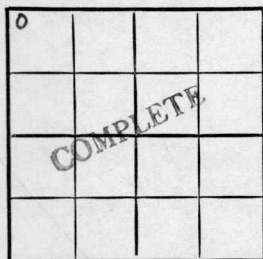330 Ft. from W. Line

Butler County

Location _____

Rig up _____

Drilling and Remarks:

8 5/8" @ 169

Chert. 2439-41

5" @ 2441

TD 2482

S/ 8 bo 8 bwpd

42/ 2463-72

1000 acid

Comp. 15 bopd
Date _____

RECORD

Cased _____ in., _____ ft.

Sand _____

Gas _____

Oil _____

Total Depth 2482

PRODUCTION

1st 24 hrs. Nat. _____

1st 24 hrs. after shot _____

Gas _____ Cu. Ft.

Dry Hole _____

Abandoned _____

JUN 28 1950

19

J. E. TYRA Scout