


Map No. K 14 Sec. 7 Twp. 23 R. 4Well No. 3 Eyestone FarmGypsy et al Company

NORTH

WEST

EAST

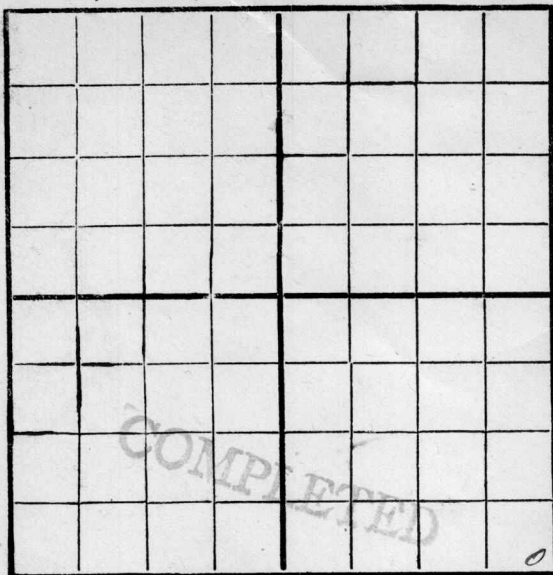

SOUTH

Location _____

Rig Up 8/12/19

Drilling Remarks:

Drilling Remarks:

RECORD

Cased _____ in. _____ ft.

Sand _____

Gas _____

Oil _____

Total Depth _____

PRODUCTION


1st 24 hrs. Nat. _____

1st 24 hrs. after shot _____

Gas _____ cu. ft.

Dry Hole _____

Abandoned _____

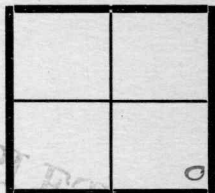Map No. _____ Sec. 7 Twp. 23 R. 4Well No. 3 Eyestone Farm _____Gypsy Oil Co. Company __________
Contractor __________
Quarter __________
Ft. from N. Lice200 Ft. from S. Line200 Ft. from E. Line_____
Ft. from W. Line

Date _____ REPORT

10/11 Dry. 2200'10/21 2403-2411 1/2 - 2300' Oil in Loc10/31 2403-2411 1/2 - 2300' Oil in Loc
2" casing, big pipe - tubing11/4 sand 2403-2411 1/2 - 2300' Oil in Loc11/11 sand 2403-2411 1/2 H.F.O.


10 for Engine

11/11 sand 2403-2411 1/2

200 bbl Natural

COMPLETED

Map No. K14 Sec. 7 Twp. 23 R. 4
Well No. 3 Eyestone
Hypox et al Company
Contractor

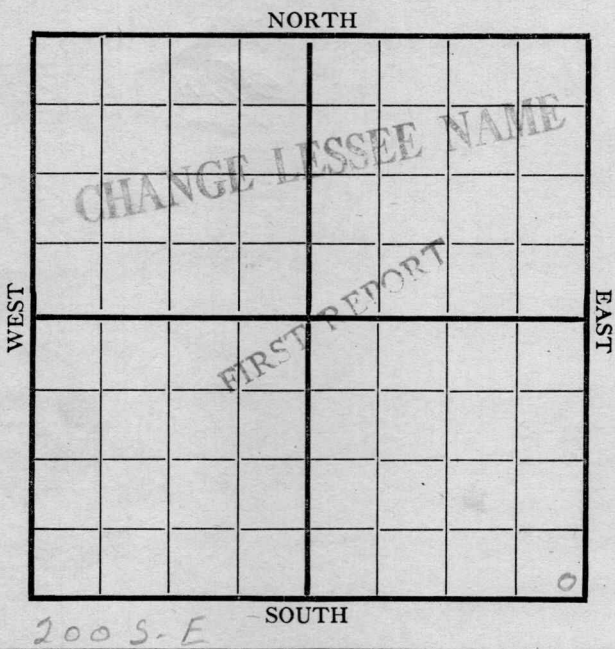


	RECORD
Location _____	Cased _____ in., _____ ft.
Rig up ☒ _____	Sand _____
Drilling and Remarks:	Gas _____
	Oil _____
	Total Depth _____
	PRODUCTION
	1st 24 hrs. Nat. _____
	1st 24 hrs. after shot _____
	Gas _____ Cu. Ft.
	Dry Hole _____
	Abandoned _____

Date 8/12 1919 Cyler Scout

Sec. 7 Twp. 23 Rge. 4
Owner Sydney Oil et al
Farm Epestone Well No. 3
Contractor _____

Feet from lines, N. _____ E. 200 S. 200 W. _____

Casing used _____
15 1/2 _____ ft.
12 1/2 _____ ft.
10 _____ ft.
8 1/4 _____ ft.
6 5/8 _____ ft.
5 3/16 _____ ft.
Location _____
Rig _____

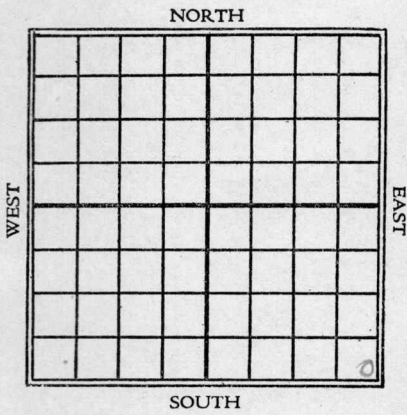

Drilling at _____ ft. Fishing at _____ ft.
Total Depth _____ Completed _____
1st 24 Hrs. Nat. _____ Producing _____
1st 24 Hrs. Shot _____ Dry Hole _____
Gas _____ Cu. ft. Abandoned _____
Sands — give name and depth. Top _____ Bottom _____

Moving in toabs

Date of Report 8/23
Reported by _____

Pyle

Map No. 1514 Sec. 7 Twp. 23 R. 4Well No. 3 ExhaustoneGypsy Oil and Company

Contractor

SECTION PLAT

Ft. from N. Line

200 Ft. from S. Line200 Ft. from E. Line

Ft. from W. Line

Location

Rig up

Drilling and Remarks:

Rig'n up

RECORD

Cased _____ in., _____ ft.

Sand _____

Gas _____

Oil _____

Total Depth _____

PRODUCTION

1st 24 hrs. Nat. _____

1st 24 hrs. after shot _____

Gas _____ Cu. Ft.

Dry Hole _____

Abandoned _____

Date

8/30 1919

Pyle

Scout

Map No. K14 Sec. 7 Twp. 23 R. 4Well No. 3 EucalyptusHypso et al Company

Contractor

SECTION PLAT

Ft. from N. Line

200 Ft. from S. Line200 Ft. from E. Line

Ft. from W. Line

			0

Location

Rig up

Drilling and Remarks:

525'

RECORD

Cased _____ in., _____ ft.

Sand _____

Gas _____

Oil _____

Total Depth _____

PRODUCTION

1st 24 hrs. Nat. _____

1st 24 hrs. after shot _____

Gas _____ Cu. Ft.

Dry Hole _____

Abandoned _____

Date

9/2 191 9

Pyle

Scout

Map No. K 14 Sec. 7 Twp. 23 R. 4
Well No. 3 Eyestone
Typosy Oil and Gas Company
Contractor

SECTION PLAT

-----Ft. from N. Line
200 Ft. from S. Line
200 Ft. from E. Line
-----Ft. from W. Line

			0

Location -----
Rig up -----
Drilling and Remarks:

S. D @
525
boiler trouble

RECORD

Cased ----- in., ----- ft.
Sand -----
Gas -----
Oil -----
Total Depth -----

PRODUCTION

1st 24 hrs. Nat. -----
1st 24 hrs. after shot -----
Gas ----- Cu. Ft.
Dry Hole -----
Abandoned -----

Date 9/9 1919 Pyle Scout

Map No. K14 Sec. 7 Twp. 23 R. 4Well No. 3 EyestoneLypsey et al Company

Contractor

SECTION PLAT

-----Ft. from N. Line

200 Ft. from S. Line200 Ft. from E. Line

-----Ft. from W. Line

			0

Location -----

Rig up -----

Drilling and Remarks:

1200'

RECORD

Cased ----- in., ----- ft.

Sand -----

Gas -----

Oil -----

Total Depth -----

PRODUCTION

1st 24 hrs. Nat. -----

1st 24 hrs. after shot -----

Gas ----- Cu. Ft.

Dry Hole -----

Abandoned -----

Date

9/15 191 9

Pyle

Scout

Map No. K 14 Sec. 7 Twp. 23 R. 4Well No. 3 EyeestoneLufay Oil et al Company

Contractor

SECTION PLAT

-----Ft. from N. Line

700 Ft. from S. Line700 Ft. from E. Line

-----Ft. from W. Line

			0

Location -----

Rig up -----

Drilling and Remarks:

1590

RECORD

Cased ----- in., ----- ft.

Sand -----

Gas -----

Oil -----

Total Depth -----

PRODUCTION

1st 24 hrs. Nat. -----

1st 24 hrs. after shot -----

Gas ----- Cu. Ft.

Dry Hole -----

Abandoned -----

Date

9/23 191 9

Pyle

Scout

Map No. K 14 Sec. 7 Twp. 23 R. 4

Well No. 3 Eye stone

Hypox Oil Co Company
Contractor

SECTION PLAT

-----Ft. from N. Line

200 Ft. from S. Line

200 Ft. from E. Line

-----Ft. from W. Line

Location -----

Rig up -----

Drilling and Remarks:

RECORD

Cased ----- in., ----- ft.

Sand -----

Gas -----

Oil -----

Total Depth -----

PRODUCTION

1st 24 hrs. Nat. -----

1st 24 hrs. after shot -----

Gas ----- Cu. Ft.

Dry Hole -----

Abandoned -----

Date

9/30 1919 Pyle Scout

Map No. 1514 Sec. 7 Twp. 23 R. 4Well No. 3 EyestoneHydco et al Company

Contractor

SECTION PLAT

-----Ft. from N. Line

200 Ft. from S. Line200 Ft. from E. Line

-----Ft. from W. Line

			o

Location -----

Rig up -----

Drilling and Remarks:

2200 Dry

RECORD

Cased ----- in., ----- ft.

Sand -----

Gas -----

Oil -----

Total Depth -----

PRODUCTION

1st 24 hrs. Nat. -----

1st 24 hrs. after shot -----

Gas ----- Cu. Ft.

Dry Hole -----

Abandoned -----

Date

Pyle

10/14 1919

Scout

Map No. 1514 Sec. 7 Twp. 23 R. 4Well No. 3 EyestoneDipsey et al Company

Contractor

SECTION PLAT

			o

-----Ft. from N. Line

200 Ft. from S. Line200 Ft. from E. Line

-----Ft. from W. Line

RECORD

Location -----

Rig up -----

Drilling and Remarks:

Cased ----- in., ----- ft.

Sand 2403 - 2411 1/2

Gas -----

Oil -----

Total Depth -----

PRODUCTION

1st 24 hrs. Nat. -----

1st 24 hrs. after shot -----

Gas ----- Cu. Ft.

Dry Hole -----

Abandoned -----

Date

Pyle

10/21 191 9

Scout

Map No. 1514 Sec. 7 Twp. 23 R. 4Well No. 3 EsystoneGypsy Oil et al Company

Contractor

SECTION PLAT

Ft. from N. Line

200 Ft. from S. Line200 Ft. from E. Line

Ft. from W. Line



Location

Rig up

Drilling and Remarks:

RECORD

Cased in., ft.

Sand 2403 - 2411 1/2

Gas

Oil

Total Depth

PRODUCTION

1st 24 hrs. Nat. 200 bbls

1st 24 hrs. after shot

Gas Cu. Ft.

Dry Hole

Abandoned

Date

11/11 1919

Pyle

Scout