

Map No.

Sec.

Twp.

R.

Well No.

RGS Farm


Company

Watchorn Oil & Gas

NORTH

WEST

EAST

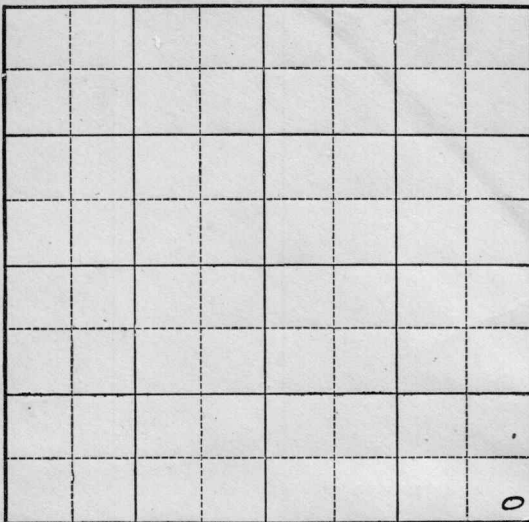

SOUTH

OWSS

Location

Rig up

Drilling Remarks:

Drilling Remarks:

RECORD

PRODUCTION

Cased in. ft.

Sand

Gas

Oil

Total Depth

1st 24 hrs Nat.

1st 24 hrs. after shot

Gas cu. ft.

Dry Hole

Abandoned

Map No. Harvey 4-23-2E Sec. 27 Twp. 22 R. 2Well No. 1 Symons Brandywiser FarmL. G. Hunter Company
Watchorn Oil & Gas

NORTH

Ft. from N. Line


200

Ft. from S. Line

200

Ft. from E. Line

Ft. from W. Line

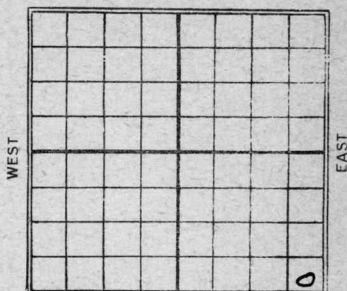

SOUTH

Beneas

REPORT

page

<u>6/10</u>	<u>Location</u>
<u>10/28</u>	<u>spud</u>
<u>11/26</u>	<u>Spudded & S.D.</u>
<u>1925</u>	<u>_____</u>
<u>6/2</u>	<u>_____</u>
<u>8/14</u>	<u>_____</u>
<u>8/19</u>	<u>_____</u>
<u>8/26</u>	<u>_____</u>
<u>9/30</u>	<u>_____</u>
<u>12/30</u>	<u>J.O. 927 - D & A. Leases expired</u>
<u>1926</u>	<u>10WSS?</u>
	<u>Shut-in</u>
<u>5/5</u>	<u>_____</u>
<u>5/12</u>	<u>Same.</u>
<u>5-26</u>	<u>Underream 8" T.D. 2580</u>
<u>6/2</u>	<u>U.R. 8" T.D. 2580</u>
<u>6/16</u>	<u>T.D. 2588 Run 8" C 2565</u>
<u>6/23</u>	<u>D.lg 2630</u>
<u>6/30</u>	<u>" 2700</u>
<u>7/14</u>	<u>" 2900</u>
<u>7/21</u>	<u>" 2970</u>
<u>8/4</u>	<u>Abandoned 3237</u>

24 *Harvey*
Map No. **KANSAS** Sec. *27* Twp. *22* R. *2 E*

Well No. *#1 Symons*
S.A. Hunter Company

Contractor

FIRST REPORT

SECTION PLAT

_____ Ft. from N. Line
200 _____ Ft. from S. Line
200 _____ Ft. from E. Line
_____ Ft. from W. Line

			0

Location *✓ ✓* _____
Rig up _____
Drilling and Remarks:

RECORD

Cased _____ in., _____ ft.
Sand _____
Gas _____
Oil _____
Total Depth _____

PRODUCTION

1st 24 hrs. Nat. _____
1st 24 hrs. after shot _____
Gas _____ Cu. Ft.
Dry Hole _____
Abandoned _____

Date

M. A. BENEAR

JUN 10 1924
192

Scout

24 Harvey
 Map No. **KANSAS** Sec. 27 Twp. 22 R. 2E

Well No. 1 Symons

S. R. Hunter Company

Contractor

SECTION PLAT

_____ Ft. from N. Line

200 Ft. from S. Line

200 Ft. from E. Line

_____ Ft. from W. Line

ABANDONED

			0

Location _____

Rig up _____

Drilling and Remarks:

TD 927

D & H.

Leases expired

RECORD

Cased _____ in., _____ ft.

Sand _____

Gas _____

Oil _____

Total Depth _____

PRODUCTION

1st 24 hrs. Nat. _____

1st 24 hrs. after shot _____

Gas _____ Cu. Ft.

Dry Hole _____

Abandoned _____

Date

DEC 30 1925

192

S. J. LEWIS

Scout


K34
 Map No. **KANSAS** Sec. *27* Twp. *22* R. *2E*

Well No. *1 Symons*

Watchorn Oil & Gas Company

Contractor

SECTION PLAT

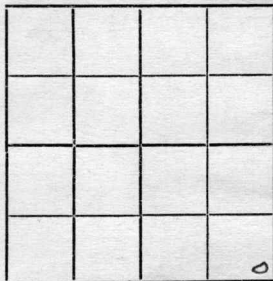

-----Ft. from N. Line

200 Ft. from S. Line

200 Ft. from E. Line

-----Ft. from W. Line

Collection DW 50

Location -----

Rig up -----

Drilling and Remarks:

S.A. Hunter
128 Leases expiring
and not a band back
a 8927.

Watchorn now
going to drill

RECORD

Cased ----- in., ----- ft.

Sand -----

Gas -----

Oil -----

Total Depth -----

PRODUCTION

1st 24 hrs. Nat. -----

1st 24 hrs. after shot -----

Gas ----- Cu. Ft.

Dry Hole -----

Abandoned -----

Date

APR 20 1926

S. J. LEWIS

Scout

K24 Harvey

Map No. **KANSAS** Sec. 33 Twp. 22 R. 2E

Well No. 1 Brandywine

Hatchorn Oil & Gas Company

Contractor

SECTION PLAT

Ft. from N. Line

200 Ft. from S. Line

200 Ft. from E. Line

Ft. from W. Line

			0

Correction

Location

Rig up

Drilling and Remarks:

I reported this

in 27-22-2E

Should be

33-22-2E

RECORD

Cased in., ft.

Sand

Gas

Oil

Total Depth

PRODUCTION

1st 24 hrs. Nat.

1st 24 hrs. after shot

Gas Cu. Ft.

Dry Hole

Abandoned

Date

JUN 9 1926

192

S. J. LEWIS

Scout

13
 Map No. KANSAS Sec. 4 Twp. 23 R. 2E

Well No. 1 Brantley
Watson Oil & Gas Company

Contractor

SECTION PLAT

			0

_____ Ft. from N. Line

200 Ft. from S. Line

200 Ft. from E. Line

_____ Ft. from W. Line

Correction

Location _____

Rig up _____

Drilling and Remarks:

Reported this
in 33-22-2E.

should be the
old Wentworth
hole in 4-23-2E
which was taken
over by Watson
Oil & Gas.

RECORD

Cased _____ in., _____ ft.

Sand _____

Gas _____

Oil _____

Total Depth _____

PRODUCTION

1st 24 hrs. Nat. _____

1st 24 hrs. after shot _____

Gas _____ Cu. Ft.

Dry Hole _____

Abandoned _____

Date

AUG 4 1926

192

S. J. LEWIS

Scout

Map No. 13 KANSAS Sec. 4 Twp. 23 R. 2EWell No. 1 BrantpurigerKatchorn Oil & Gas Company

Contractor

SECTION PLAT

			0

Ft. from N. Line

200 Ft. from S. Line200 Ft. from E. Line

Ft. from W. Line

ABANDONED

Location

Rig up

Drilling and Remarks:

TII 3237 HFVHYA.

RECORD

Cased _____ in., _____ ft.

Sand _____

Gas _____

Oil _____

Total Depth _____

PRODUCTION

1st 24 hrs. Nat. _____

1st 24 hrs. after shot _____

Gas _____ Cu. Ft.

Dry Hole _____

Abandoned _____

Date

AUG 4 1926192S. J. LEWIS

Scout

Harvey.
 Map No. KANSAS Sec. 4 Twp. 23 R. 2E

Well No. 1 Brantzywizer
Ven Thore & Dal Company

Contractor

SECTION PLAT

-----Ft. from N. Line

200 Ft. from S. Line

200 Ft. from E. Line

-----Ft. from W. Line

			0

Correction

Location -----

Rig up -----

Drilling and Remarks:

This was reported
in SW. NW. NE.

and should have

been SE SE.

and the farm.

name is Brantzy

wizer not M.

RECORD

Cased ----- in., ----- ft.

Sand -----

Gas -----

Oil -----

Total Depth -----

PRODUCTION

1st 24 hrs. Nat. -----

1st 24 hrs. after shot -----

Gas ----- Cu. Ft.

Dry Hole -----

Abandoned -----

Date

DEC 15 1926

S. J. LEWIS

192

Scout

Map No. KANSAS Sec. 4 Twp. 23 R. 2E

Well No. 1 Brantzwiger

Hatchorn Oil & Gas Company

Contractor

SECTION PLAT

_____ Ft. from N. Line

200 Ft. from S. Line

200 Ft. from E. Line

_____ Ft. from W. Line

			0

Correction

Location _____

Rig up _____

Drilling and Remarks:

Hatchorn Oil & Gas

Took this hole over

from Ventworth

& Co.

Ventworth & Co.

drilled it to 2486

RECORD

Cased _____ in., _____ ft.

Sand _____

Gas _____

Oil _____

Total Depth _____

PRODUCTION

1st 24 hrs. Nat. _____

1st 24 hrs. after shot _____

Gas _____ Cu. Ft.

Dry Hole _____

Abandoned _____

Date

DEC 15 1902

S. J. LEWIS

Scout

13 Harvey.
 Map No. KANSAS Sec. 4 Twp. 23 R. 2E
 Well No. 1 Brantwyger
Watchorn Oil & Gas Company

Contractor

SECTION PLAT

-----Ft. from N. Line

200 Ft. from S. Line

200 Ft. from E. Line

-----Ft. from W. Line

ABANDONED

Location -----

Rig up -----

Drilling and Remarks:

TJ 3237 AFM

IIA

RECORD

Cased ----- in., ----- ft.

Sand -----

Gas -----

Oil -----

Total Depth -----

PRODUCTION

1st 24 hrs. Nat. -----

1st 24 hrs. after shot -----

Gas ----- Cu. Ft.

Dry Hole -----

Abandoned -----

Date

DEC 15 1926

S. J. LEWIS