


Map No. Kansas Sec. 4 Twp. 23 R. 2^E
Well No. 1 Wann Farm
Wendworth et al Company

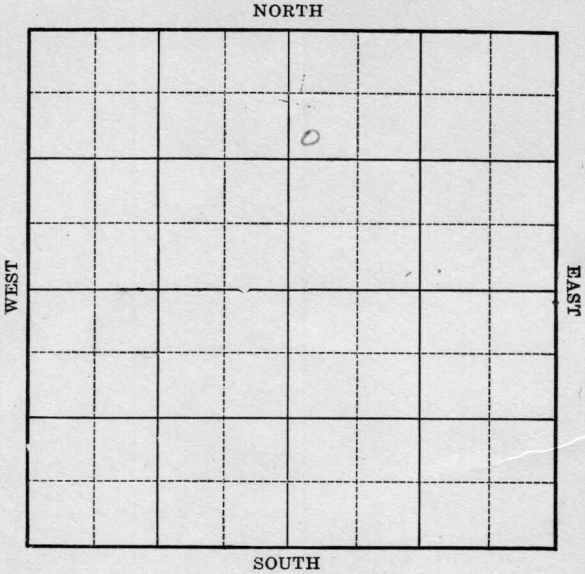

Location _____
Drilling Remarks _____

Rig Up _____
Drilling Remarks _____

RECORD

Cased _____ in. _____ ft.
Sand _____
Gas _____
Oil _____
Total Depth _____

PRODUCTION

1st 24 hrs. Nat. _____
1st 24 hrs. after shot _____
Gas _____ cu. ft.
Dry Hole _____
Abandoned _____


Map No. Kansas Sec. 4 Twp. 23 R 2EWell No. 1 Mann FarmWentworth et al Company

NORTH

WEST

EAST

SOUTH

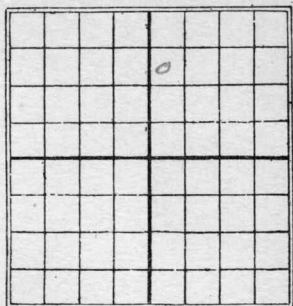990 Ft. from N. Line

Ft. from S. Line

Ft. from E. Line

300 Ft. from W. Line

Date

REPORT

19259/2 Dlg 2435'9/9 sound 2435-50'9/30 2486 SD5/5 Same.5/12 Same.6/23 _____6/30 _____7/21 _____92612/15 I.D. 3237-H.F.W.D. & A.

3 *Harvey*
 Map No. *KANSAS* Sec. *4* Twp. *23* R. *2E*

Well No. *1* *Hansen*


Contractor

SECTION PLAT

990 Ft. from N. Line

_____ Ft. from S. Line

_____ Ft. from E. Line

300 Ft. from W. Line

		0	

FIRST REPORT

Location _____

Rig up _____

Drilling and Remarks:

Log 2435

RECORD

Cased _____ in., _____ ft.

Sand _____

Gas _____

Oil _____

Total Depth _____

PRODUCTION

1st 24 hrs. Nat. _____

1st 24 hrs. after shot _____

Gas _____ Cu. Ft.

Dry Hole _____

Abandoned _____

Date

SEP 2 - 1925

S. J. LEWIS

Scout

Map No. Kansas Sec. 4 Twp. 23 R. 2EWell No. 1 Wann
Wentworth et al Company

Contractor

Completed

SECTION PLAT

990 Ft. from N. Line

Ft. from S. Line

Ft. from E. Line

300 Ft. from W. Line

		0	

Duplicateothers ticked returnedfor correction

Location

Rig up

Drilling and Remarks:

RECORD

Cased _____ in., _____ ft.

Sand _____

Gas _____

Oil _____

Total Depth _____

PRODUCTION

1st 24 hrs. Nat. _____

1st 24 hrs. after shot _____

Gas _____ Cu. Ft.

Dry Hole _____

Abandoned 3237

Date

12/15 1925 Scout


CONTRACTOR

SECTION PLAT

		10	

_____ FT. FROM N. LINE

_____ FT. FROM S. LINE

_____ FT. FROM E. LINE

_____ FT. FROM W. LINE

LOCATION _____

RIG UP _____

DRILLING AND REMARKS:

*we show
3237
not changing*

RECORD

CASED _____ IN., _____ FT.

SAND _____

GAS _____

OIL _____

TOTAL DEPTH 3486

PRODUCTION

1ST 24 HRS. NAT. _____

1ST 24 HRS. AFTER SHOT _____

GAS _____ CU. FT.

DRY HOLE ☒ABANDONED ☒

DATE

4/26

1926

SCOUT