

WEST

EAST

COMPLETED

SOUTH

Drilling Remarks:

Drilling Remarks:

Cased _____ in. _____ ft.
 Sand _____
 Gas _____
 Oil _____
 Total Depth _____

1st 24 hrs. Nat.-----
1st 24 hrs. after shot-----
Gas-----cu. ft
Dry Hole-----
Abandoned-----

Map No. _____ Sec. 3 Twp. 26 R. 4Well No. 3 Shriver Farm __________
Company _____

NORTH

SOUTH

Location _____

Rig up ☒ _____

Drilling and remarks:

RECORD

Cased _____ in. _____ Ft.

Sand _____

Gas _____

Oil _____

Total Depth _____

PRODUCTION

1st 24 hrs. Nat. _____

1st 24 hrs. after shot _____

Gas _____ Cu. Ft.

Dry Hole _____

Abandoned _____

Date

11-7, 1912, Conley Scout


FIRST REPORT

Map No. _____ Sec. 3 Twp. 26 R. 4

Well No. 3 Shriener Farm

Engine Company

NORTH

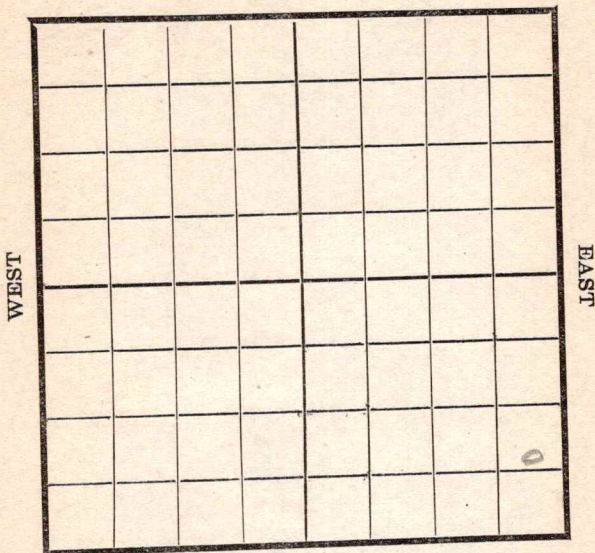

SOUTH

RECORD

Location _____

Rig Up ☒ _____

Drilling and remarks

Cased _____ in _____ Ft.

Sand _____

Gas _____

Oil _____

Total Depth _____

PRODUCTION

1st 24 hrs. Nat. _____

1st 24 hrs. after shot _____

Gas _____ Cu. Ft.

Dry Hole _____

Abandoned _____

Date


11/14, 1917 Carney Scout

Map No. _____ Sec. 3 Twp. 26 R. 4

Well No. 3 Shreve Farm _____
Angine Company

NORTH

WEST

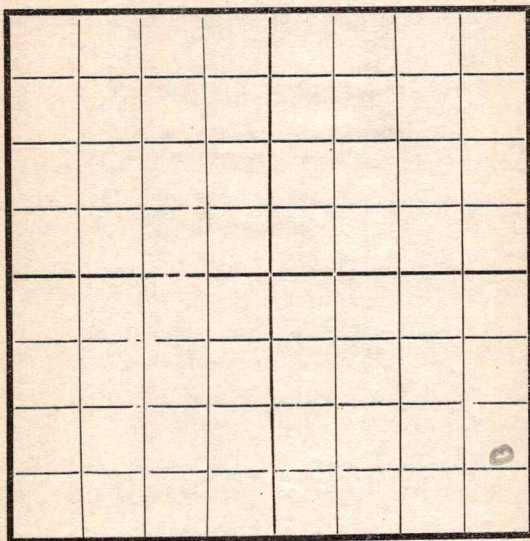

EAST

SOUTH

Location ✓

Rig Up ✓

Drilling and remarks

RECORD

Cased _____ in. _____ Ft.

Sand _____

Gas _____

Oil _____

Total Depth _____

PRODUCTION

1st 24 hrs. Nat. _____

1st 24 hrs. after shot _____

Gas _____ Cu. Ft.

Dry Hole _____

Abandoned _____


Date

11/21, 1917 Cordry Scout

Map No. _____ Sec. 3 Twp. 26 R. 4Well No. 3 Shriver FarmEmpire Company

NORTH

WEST

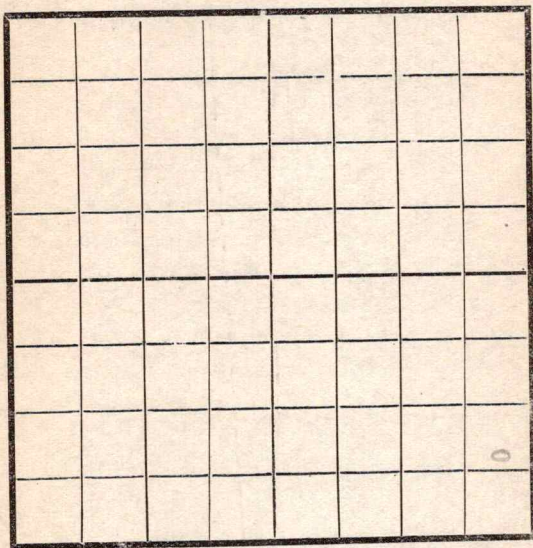

EAST

SOUTH

Location _____

Rig Up ☒ _____

Drilling and remarks _____

RECORD

Cased _____ in _____ Ft.

Sand _____

Gas _____

Oil _____

Total Depth _____

PRODUCTION

1st 24 hrs. Nat. _____

1st 24 hrs. after shot _____

Gas _____ Cu. Ft.

Dry Hole _____

Abandoned _____


Date

11/28, 1917 Cordell Scout

Map No. _____ Sec. 3 Twp. 26 R. 4Well No. 3 Shriver Farm _____Empire Company _____

NORTH

WEST

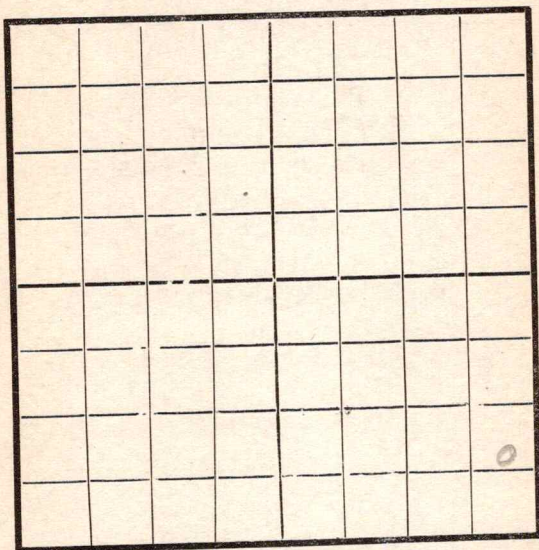

EAST

SOUTH

Location ✓Rig Up ✓

Drilling and remarks

RECORD

Cased _____ in. _____ Ft.

Sand _____

Gas _____

Oil _____

Total Depth _____

PRODUCTION

1st 24 hrs. Nat. _____

1st 24 hrs. after shot _____

Gas _____ Cu. Ft.

Dry Hole _____

Abandoned _____


Date

12/5, 1917 Condy Scout

Map No. _____ Sec. 3 Twp. 26 R. 4Well No. 3 Shriver Farm
Engine Company

NORTH

WEST

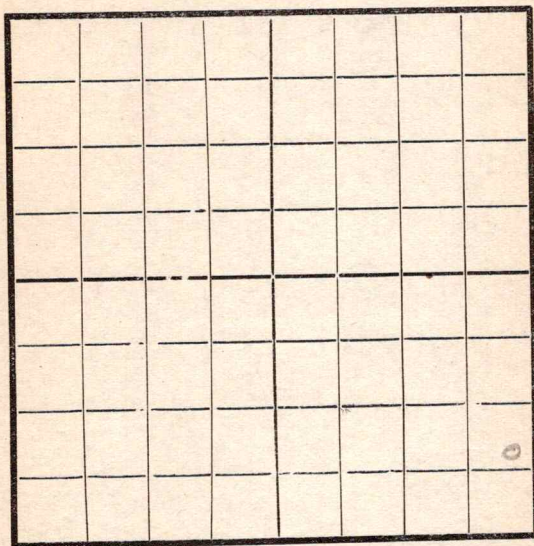

EAST

SOUTH

RECORD

Location _____

Cased _____ in. _____ Ft.

Rig Up _____

Sand _____

Drilling and remarks

Gas _____

Oil _____

Total Depth _____

PRODUCTION

1st 24 hrs. Nat. _____

1st 24 hrs. after shot _____

Gas _____ Cu. Ft.

Dry Hole _____

Abandoned _____


Date

1/3, 1918 S. Condy Scout

Map No. _____ Sec. 3 Twp. 26 R. 4Well No. 3 Shriver Farm
Empire Company

NORTH

WEST

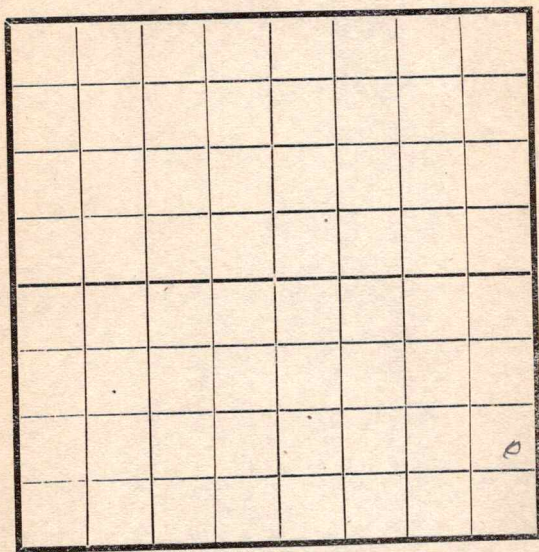

EAST

SOUTH

RECORD

Location _____

Rig Up ☒ _____

Drilling and remarks _____

Cased _____ in. _____ Ft.

Sand _____

Gas _____

Oil _____

Total Depth _____

PRODUCTION

1st 24 hrs. Nat. _____

1st 24 hrs. after shot _____

Gas _____ Cu. Ft.

Dry Hole _____

Abandoned _____

Date


1/16, 1918 S. Condy Scout

Map No. _____ Sec. 3 Twp. 26 R. 4Well No. 3 Shivers
Engine Company
Contractor

NORTH

WEST

EAST

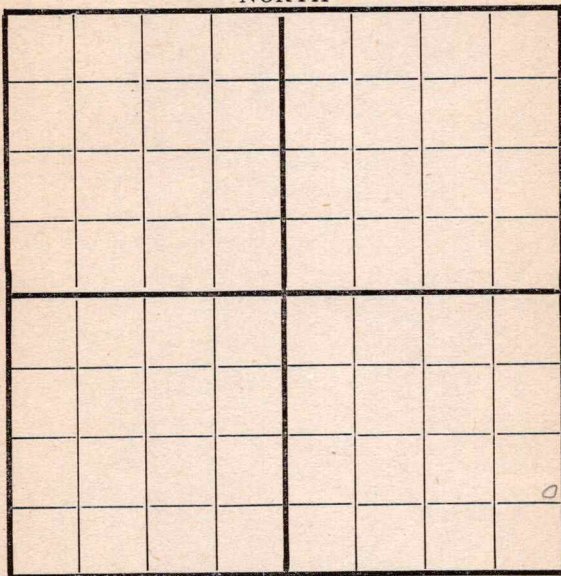

SOUTH

Location _____

Rig up _____

Drilling and Remarks:

Spending

RECORD

Cased _____ in., _____ ft.

Sand _____

Gas _____

Oil _____

Total Depth _____

PRODUCTION

1st 24 hrs. Nat. _____

1st 24 hrs. after shot _____

Gas _____ Cu. Ft.

Dry Hole _____

Abandoned _____

Date

5/10

191

S. C. Candy

Scout

Map No. K14 Sec. 3 Twp. 26 R. 4

Well No. 13 Shiner


Smiggin Company

Contractor

NORTH

WEST

EAST

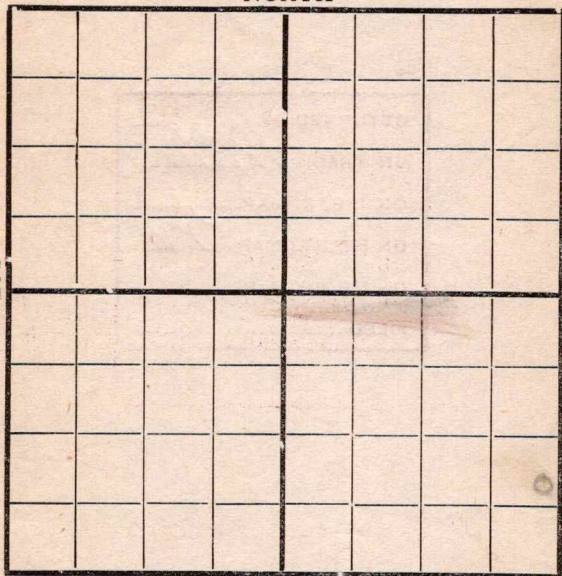

SOUTH

Location _____

Rig up ☒

Drilling and Remarks:

7/3/1918

Rig up

RECORD

Cased _____ in., _____ ft.

Sand _____

Gas _____

Oil _____

Total Depth _____

PRODUCTION

1st 24 hrs. Nat. _____

1st 24 hrs. after shot _____

Gas _____ Cu. Ft.

Dry Hole _____

Abandoned _____

Date

1/16 8

Cardiff

Map No. _____ Sec. 3 Twp. 26 R. 4Well No. 3 Shiner


Company _____

Contractor _____

NORTH

WEST

EAST

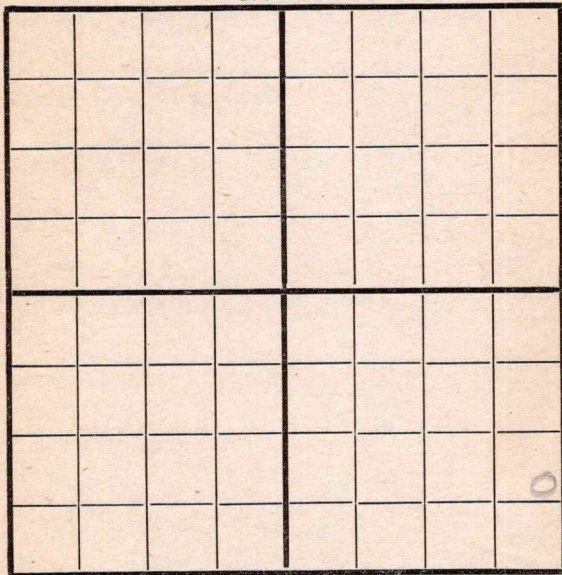

SOUTH

Location _____

Rig up _____

Drilling and Remarks:

200**RECORD**

Cased _____ in., _____ ft.

Sand _____

Gas _____

Oil _____

Total Depth _____

PRODUCTION

1st 24 hrs. Nat. _____

1st 24 hrs. after shot _____

Gas _____ Cu. Ft.

Dry Hole _____

Abandoned _____

Date

7/17 1918 C. Conley Scout

Map No. 34 Sec. 3 Twp. 26 R. 4Well No. 34 ShrineCompany Engine

Contractor _____

NORTH

WEST

EAST

SOUTH

Location _____

Rig up _____

Drilling and Remarks:

(Note - Change
this number from
#3 to #2)

200

RECORD

Cased _____ in., _____ ft.

Sand _____

Gas _____

Oil _____

Total Depth _____

PRODUCTION

1st 24 hrs. Nat. _____

1st 24 hrs. after shot _____

Gas _____ Cu. Ft.

Dry Hole _____

Abandoned _____

Date


7/24 1918 S. C. Carey Scout

Map No. _____ Sec. 3 Twp. 26 R. 4
 Well No. 30 Shriver
E. Myer Company
 Contractor _____

NORTH

WEST

EAST

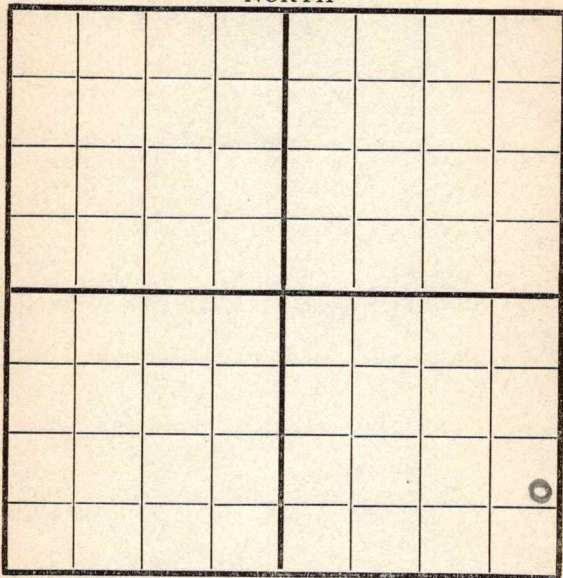

SOUTH

700' ~~17~~ SL x 300' ~~17~~ E

RECORD

Location _____

Cased _____ in., _____ ft.

Rig up _____

Sand _____

Drilling and Remarks:

Gas _____

Oil _____

Total Depth _____

PRODUCTION

1st 24 hrs. Nat. _____

1st 24 hrs. after shot _____

Gas _____ Cu. Ft.

Dry Hole _____

Abandoned _____

Date


7/31

191

8 Candy

Scout

Map No. _____ Sec. 3 Twp. 26 R. 4
Well No. 300 Shriver
Engine _____ Company _____
Contractor _____

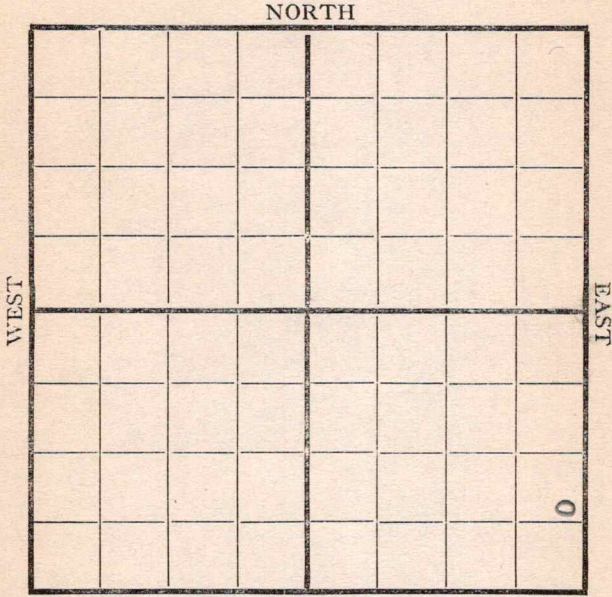

700 S
Location 200 E

Rig up _____

Drilling and Remarks:

790

RECORD

Cased _____ in., _____ ft.
Sand _____
Gas _____
Oil _____
Total Depth _____

PRODUCTION

1st 24 hrs. Nat. _____
1st 24 hrs. after shot _____
Gas _____ Cu. Ft.
Dry Hole _____
Abandoned _____

Date 8/7 1918 J. C. Cuddy Scout

Map No. _____ Sec. 3 Twp. 26 R. 4Well No. 30 Shivers


_____ Company

_____ Contractor

NORTH

WEST

EAST

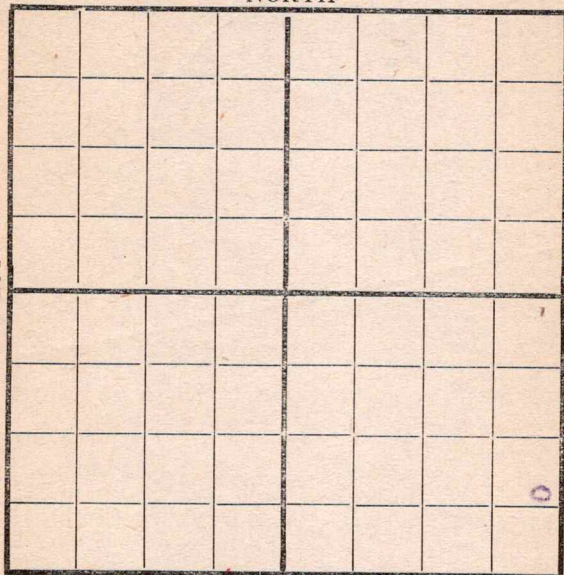

SOUTH

Location _____

Rig up _____

Drilling and Remarks:

1490'

RECORD

Cased _____ in., _____ ft.

Sand _____

Gas _____

Oil _____

Total Depth _____

PRODUCTION

1st 24 hrs. Nat. _____

1st 24 hrs. after shot _____

Gas _____ Cu. Ft.

Dry Hole _____

Abandoned _____

Date


8/5 1918Orph Scout

Map No. _____ Sec. 3 Twp. 26 R. 4Well No. 30 Shriver_____
E. J. Shriver Company_____
Contractor

NORTH

WEST

EAST

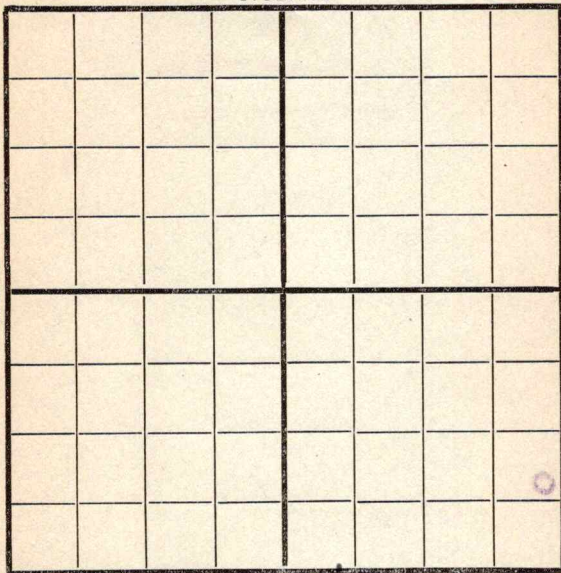

SOUTH

700' A - 200' E

Location _____

Rig up _____

Drilling and Remarks:

1770'

RECORD

Cased _____ in., _____ ft.

Sand _____

Gas _____

Oil _____

Total Depth _____

PRODUCTION

1st 24 hrs. Nat. _____

1st 24 hrs. after shot _____

Gas _____ Cu. Ft.

Dry Hole _____

Abandoned _____

Date

8/221918

Pyle

Scout


Map No. 1514 Sec. 3 Twp. 26 R. 4Well No. 31 ShriverEngine Company

Contractor

NORTH

WEST

EAST

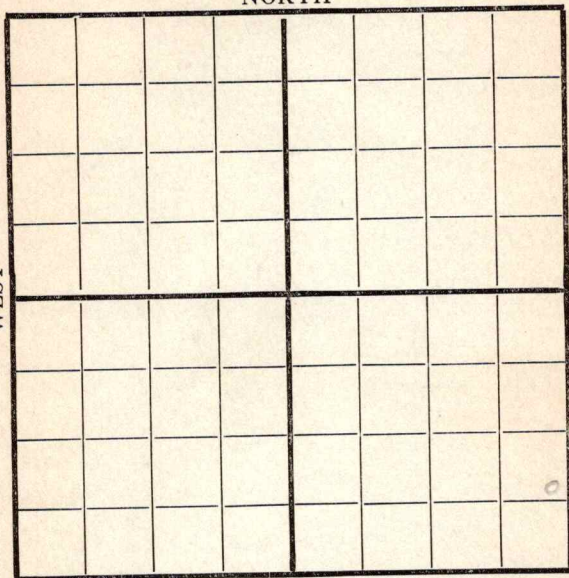

SOUTH

200 E 700 S

Location _____

Rig up _____

Drilling and Remarks:

2100

RECORD

Cased _____ in., _____ ft.

Sand _____

Gas _____

Oil _____

Total Depth _____

PRODUCTION

1st 24 hrs. Nat. _____

1st 24 hrs. after shot _____

Gas _____ Cu. Ft.

Dry Hole _____

Abandoned _____

Date

8/28

191

P. Condy

Scout

Map No. 1514 Sec. 3 Twp. 26 R. 4

Well No. 2 Shriver


Engines Company

Contractor

NORTH

WEST

EAST

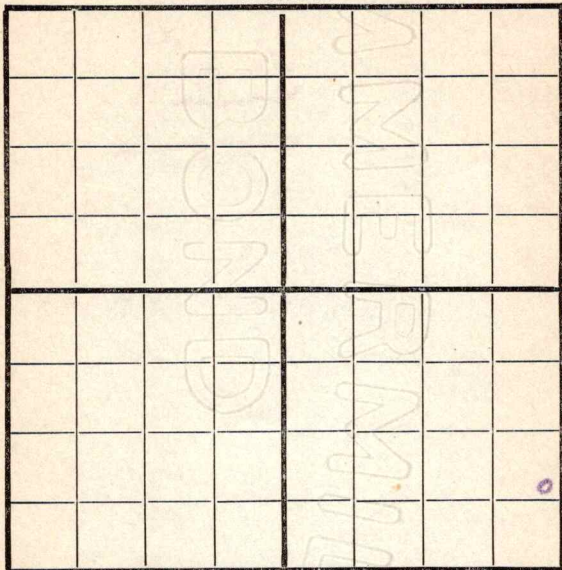

SOUTH

200 E 700 S

Location _____

Rig up _____

Drilling and Remarks:

2200

RECORD

Cased _____ in., _____ ft.

Sand _____

Gas _____

Oil _____

Total Depth _____

PRODUCTION

1st 24 hrs. Nat. _____

1st 24 hrs. after shot _____

Gas _____ Cu. Ft.

Dry Hole _____

Abandoned _____

Date

9/4

191

S. Landry

Scout


Map No. N 14 Sec. 3 Twp. 26 R. 4Well No. 25 ShinerEmpire Company

Contractor

NORTH

WEST

EAST

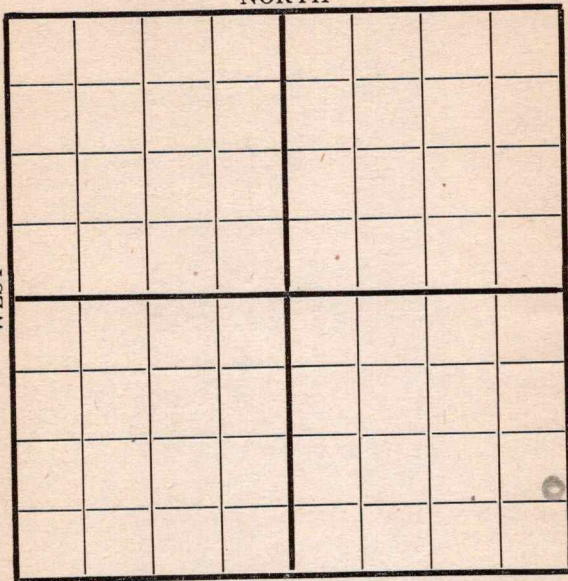

700 S 200 E SOUTH

Location

Rig up

Drilling and Remarks:

7.5

2388

RECORD

Cased in., ft.

Sand

Gas

Oil

Total Depth

PRODUCTION

1st 24 hrs. Nat.

1st 24 hrs. after shot

Gas Cu. Ft.

Dry Hole

Abandoned

Date

9/11

1918

C. C. C. C.

Scout

Map No. 1514 Sec. 3 Twp. 26 R. 4Well No. 3 Shriver FarmCummins Company

NORTH

WEST

COMPLETED

EAST

SOUTH

700 S - 300 E

Location _____

Rig up _____

Drilling and remarks:

Est at
100 ✓ bbls

RECORD

Cased _____ in. _____ Ft.

Sand 2388-2446

Gas _____

Oil _____

Total Depth _____

PRODUCTION

1st 24 hrs. Nat. _____

1st 24 hrs. after shot _____

Gas _____ Cu. Ft.

Dry Hole _____

Abandoned _____

Date

9/18

, 191

S. C. Cady

Scout