

Map No. _____ Sec. 3 Twp. 26 R. 4
Well No. 5-Shriver Farm _____
Empire Company

NORTH



SOUTH

Location _____

Drilling Remarks:

RECORD

Cased _____ in. _____ ft.
Sand _____
Gas _____
Oil _____
Total Depth _____

Rig Up _____

Drilling Remarks:

PRODUCTION

1st 24 hrs. Nat. _____
1st 24 hrs. after shot _____
Gas _____ cu. ft
Dry Hole _____
Abandoned _____

Map No. _____ Sec. 3 Twp. 26 R. 4

Well No. 50hriner Farm _____

McQuinn Company _____

NORTH

WEST

EAST

SOUTH

Location _____

Rig up ☒ _____

Drilling and remarks:

RECORD

Cased _____ in. _____ Ft.

Sand _____

Gas _____

Oil _____

Total Depth _____

PRODUCTION

1st 24 hrs. Nat. _____

1st 24 hrs. after shot _____

Gas _____ Cu. Ft.

Dry Hole _____

Abandoned _____

FIRST REPORT

Date

11-7, 1917, Carney Scout


Map No. _____ Sec. 3 Twp. 26 R. 4

Well No. 5 Shriver Farm _____
Engine Company _____

NORTH

WEST

EAST

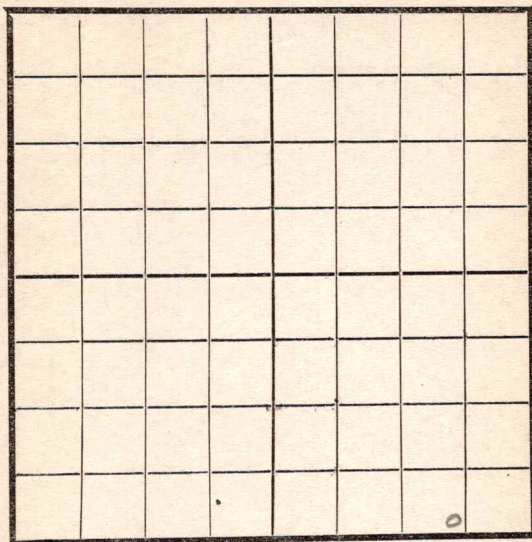

SOUTH

Location _____
 Rig Up ✓ _____
 Drilling and remarks _____

RECORD

Cased _____ in. _____ Ft.
 Sand _____
 Gas _____
 Oil _____
 Total Depth _____

PRODUCTION

1st 24 hrs. Nat. _____
 1st 24 hrs. after shot _____
 Gas _____ Cu. Ft.
 Dry Hole _____
 Abandoned _____


Date

11/14, 1917 Condy Scout

Map No. _____ Sec. 3 Twp. 26 R. 4Well No. 5 Oliver Farm _____Empire Company _____

NORTH

WEST

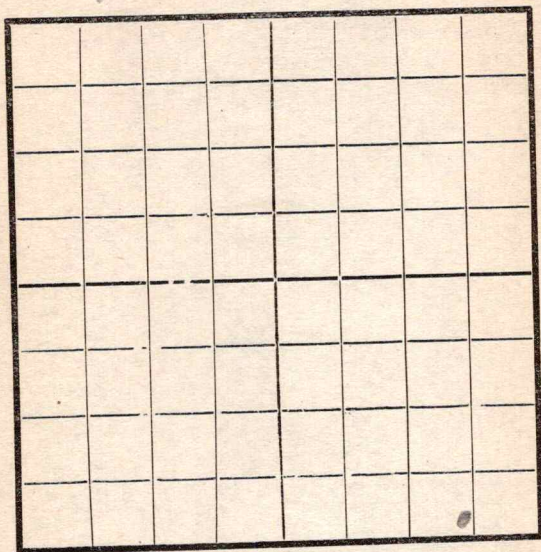

EAST

SOUTH

Location ✓

Rig Up _____

Drilling and remarks _____

RECORD

Cased _____ in. _____ Ft.

Sand _____

Gas _____

Oil _____

Total Depth _____

PRODUCTION

1st 24 hrs. Nat. _____

1st 24 hrs. after shot _____

Gas _____ Cu. Ft.

Dry Hole _____

Abandoned _____

Date


11/21, 1917 Cand Scout

Map No. _____ Sec. 3 Twp. 26 R. 4

Well No. 5 Shiner Farm _____
E. M. M. Co. Company

NORTH

WEST

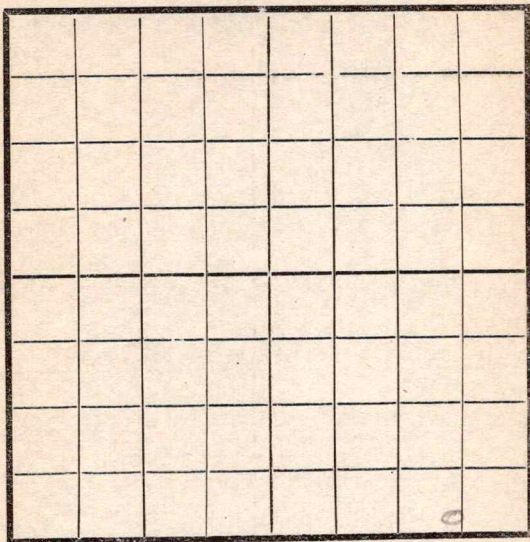

EAST

SOUTH

Location _____

Rig Up ☒ _____

Drilling and remarks _____

RECORD

Cased _____ in. _____ Ft.

Sand _____

Gas _____

Oil _____

Total Depth _____

PRODUCTION

1st 24 hrs. Nat. _____

1st 24 hrs. after shot _____

Gas _____ Cu. Ft.

Dry Hole _____

Abandoned _____


Date

11/28, 1917 C. M. M. Co. Scout

Map No. _____ Sec. 3 Twp. 26 R. 4
 Well No. 5 Shriver Farm _____
Engine Company _____

NORTH

WEST

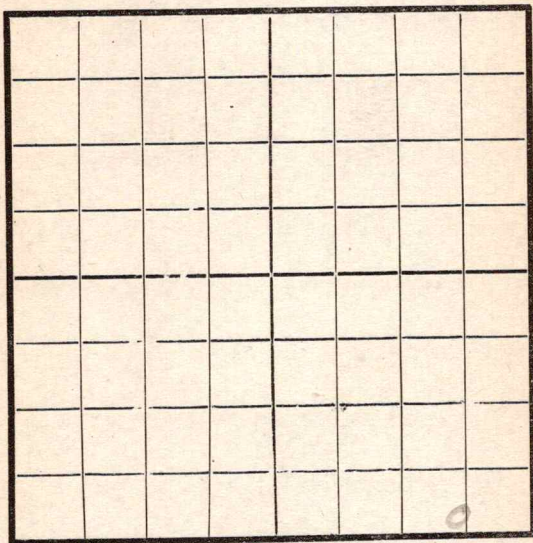

EAST

SOUTH

Location _____

Rig Up _____

Drilling and remarks _____

RECORD

Cased _____ in. _____ Ft.

Sand _____

Gas _____

Oil _____

Total Depth _____

PRODUCTION

1st 24 hrs. Nat. _____

1st 24 hrs. after shot _____

Gas _____ Cu. Ft.

Dry Hole _____

Abandoned _____


Date

12/5, 1917 Condy Scout

Map No. _____ Sec. 3 Twp. 36 R. 4Well No. 5 Shriver Farm
Empire Company

NORTH

WEST

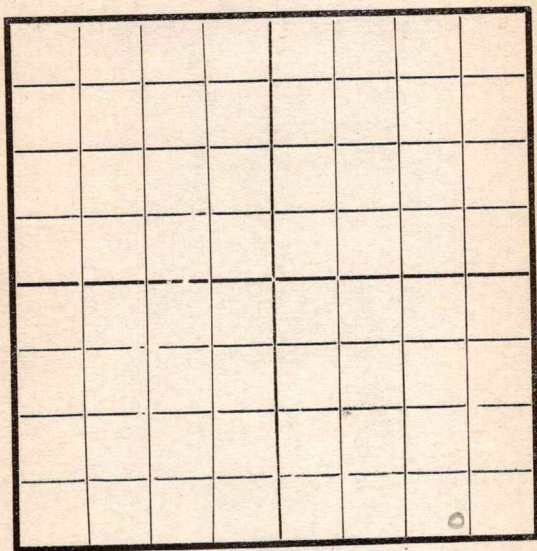

EAST

SOUTH

Location _____

Rig Up ☒ _____

Drilling and remarks

RECORD

Cased _____ in. _____ Ft.

Sand _____

Gas _____

Oil _____

Total Depth _____

PRODUCTION

1st 24 hrs. Nat. _____

1st 24 hrs. after shot _____

Gas _____ Cu. Ft.

Dry Hole _____

Abandoned _____


Date

1/2, 1918 C. C. C. C. Scout

Map No. _____ Sec. 3 Twp. 26 R. 4Well No. 5 Shiner Farm
Empire Company

NORTH

WEST

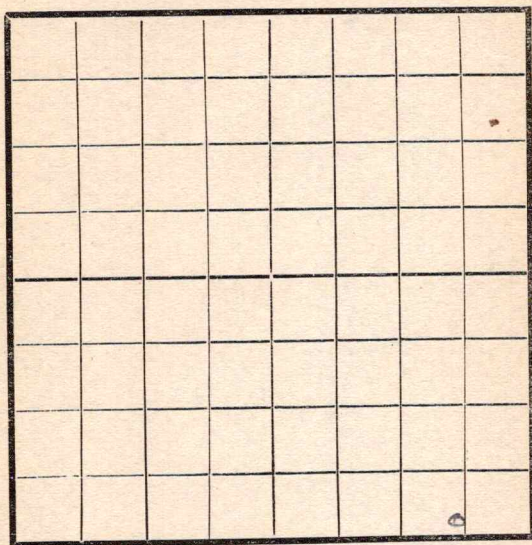

EAST

SOUTH

RECORD

Location _____

Cased _____ in. _____ Ft.

Rig Up _____

Sand _____

Drilling and remarks

Gas _____

Oil _____

Total Depth _____

PRODUCTION

1st 24 hrs. Nat. _____

1st 24 hrs. after shot _____

Gas _____ Cu. Ft.

Dry Hole _____

Abandoned _____

Date

1/16, 1918Conley

Scout


Map No. _____ Sec. 3 Twp. 26 R. 4

Well No. 5 Shriver Farm
Engine Company

NORTH

WEST

EAST

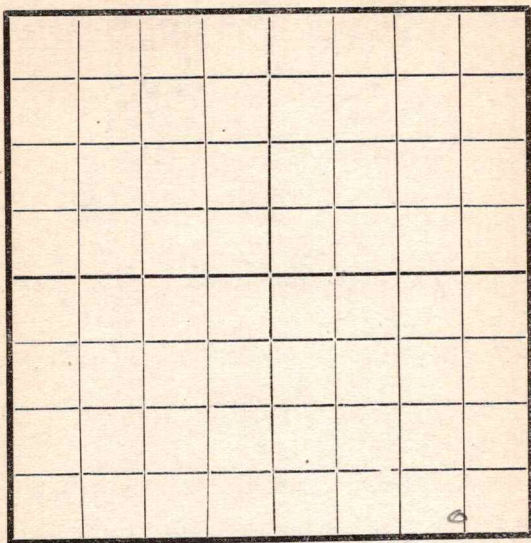

SOUTH

Location _____

Rig Up _____

Drilling and remarks

365

(Weed Dill
August)

RECORD

Cased _____ in. _____ Ft.

Sand _____

Gas _____

Oil _____

Total Depth _____

PRODUCTION

1st 24 hrs. Nat. _____

1st 24 hrs. after shot _____

Gas _____ Cu. Ft.

Dry Hole _____

Abandoned _____


Date

7/13, 1918 S. C. Cuddy Scout

Map No. _____ Sec. 3 Twp. 26 R. 4Well No. 5 Shriver FarmEngine Company

NORTH

WEST

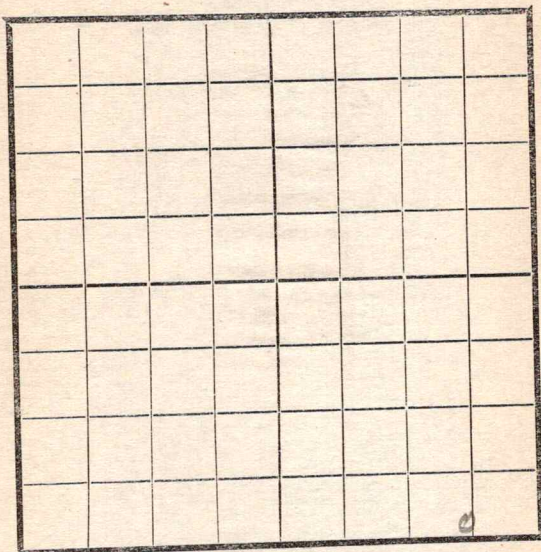

EAST

SOUTH

Location _____

Rig Up _____

Drilling and remarks

720

RECORD

Cased _____ in. _____ Ft.

Sand _____

Gas _____

Oil _____

Total Depth _____

PRODUCTION

1st 24 hrs. Nat. _____

1st 24 hrs. after shot _____

Gas _____ Cu. Ft.


Dry Hole _____

Abandoned _____

Date

2/20, 1918 S. Carney Scout

Map No. _____ Sec. 3 Twp. 26 R. 4
 Well No. 5 Shriver Farm _____
Empire Company
 NORTH

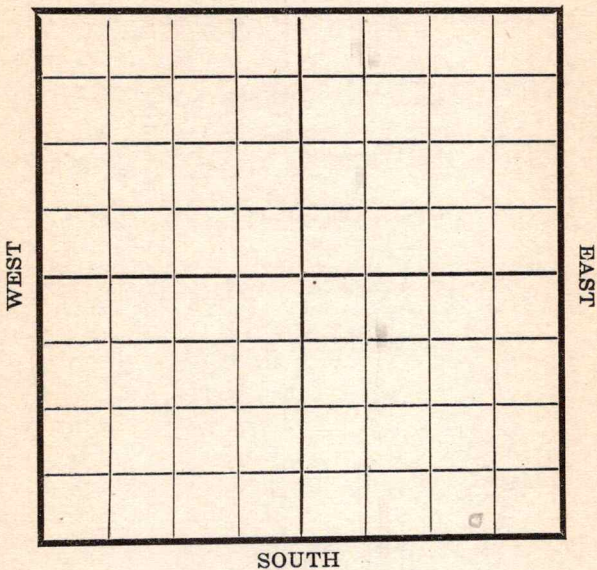

Location _____
 Rig Up _____
 Drilling and remarks

52
720

RECORD

Cased _____ in. _____ Ft.
 Sand _____
 Gas _____
 Oil _____
 Total Depth _____

PRODUCTION

1st 24 hrs. Nat. _____
 1st 24 hrs. after shot _____
 Gas _____ Cu. Ft.
 Dry Hole _____
 Abandoned _____

Date


4/27, 1918 E. E. Eddy Scout

Map No. _____ Sec. 3 Twp. 26 R. 4

Well No. 5 Shriver Farm
Engine Company

NORTH

WEST

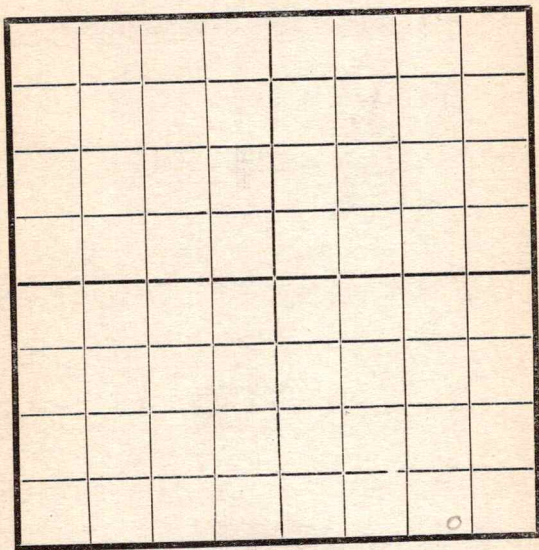

EAST

SOUTH

RECORD

Location _____

Cased _____ in. _____ Ft.

Rig Up _____

Sand _____

Drilling and remarks

Gas _____

Oil _____

Total Depth _____

860

PRODUCTION

1st 24 hrs. Nat. _____

1st 24 hrs. after shot _____

Gas _____ Cu. Ft.

Dry Hole _____

Abandoned _____

Date


3/6, 1918 C. Co. Drilling Scout

Map No. _____ Sec. 3 Twp. 26 R. 4
 Well No. 5 Shriners Farm _____
Empire Company

NORTH

WEST

EAST

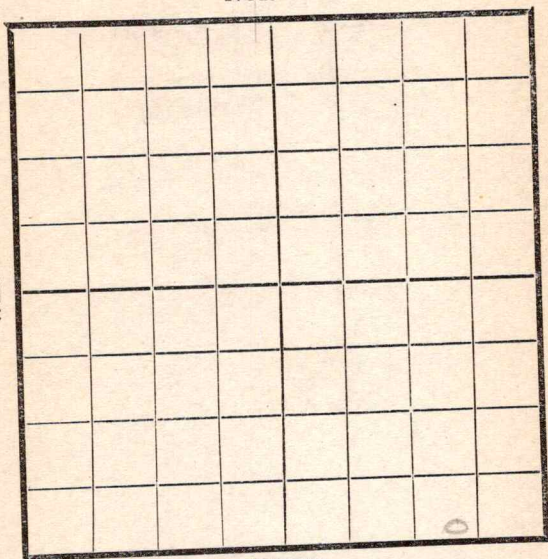

SOUTH

RECORD

Location _____
 Rig Up _____
 Drilling and remarks

Cased _____ in. _____ Ft.
 Sand _____
 Gas _____
 Oil _____
 Total Depth _____

PRODUCTION

1st 24 hrs. Nat. _____
 1st 24 hrs. after shot _____
 Gas _____ Cu. Ft.
 Dry Hole _____
 Abandoned _____


1370

Date

3/13, 1918 S. Condy Scout

Map No. _____ Sec. 3 Twp. 26 R. 4
 Well No. 5 Shriver Farm _____
Empire Company _____
 NORTH

WEST

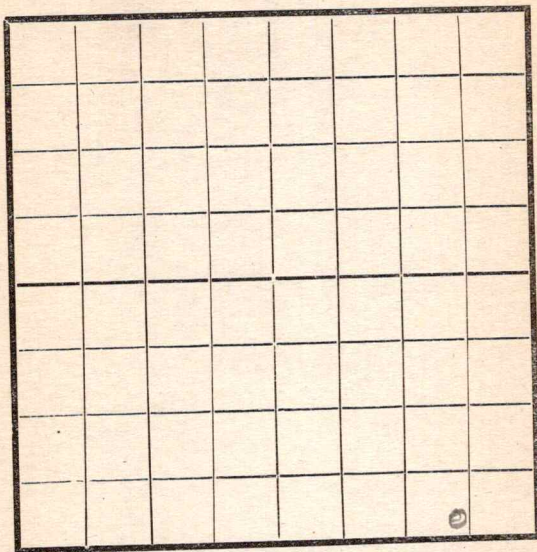

EAST

SOUTH

Location _____
 Rig Up _____
 Drilling and remarks

1545

RECORD

Cased _____ in. _____ Ft.
 Sand _____
 Gas _____
 Oil _____
 Total Depth _____

PRODUCTION

1st 24 hrs. Nat. _____
 1st 24 hrs. after shot _____
 Gas _____ Cu. Ft.
 Dry Hole _____
 Abandoned _____

Date


3/20, 1918 C. C. C. Scout

Map No. _____ Sec. 3 Twp. 26 R. 4Well No. 5 Skrin Farm _____

Company _____

NORTH

WEST

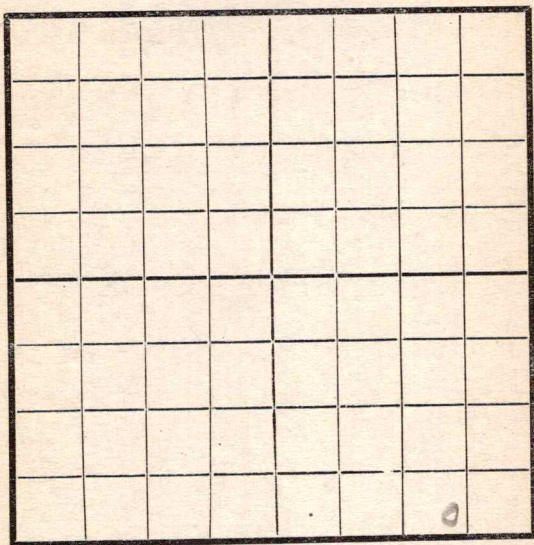

EAST

SOUTH

RECORD

Location _____

Cased _____ in. _____ Ft.

Rig Up _____

Sand _____

Drilling and remarks

Gas _____

Oil _____

Total Depth _____

PRODUCTION

1st 24 hrs. Nat. _____

1st 24 hrs. after shot _____

Gas _____ Cu. Ft.


Dry Hole _____

Abandoned _____

Date

3/27, 1918 Candy Scout

Map No. _____ Sec. 3 Twp. 26 R. 4
 Well No. 5 Shriver
Empire Company

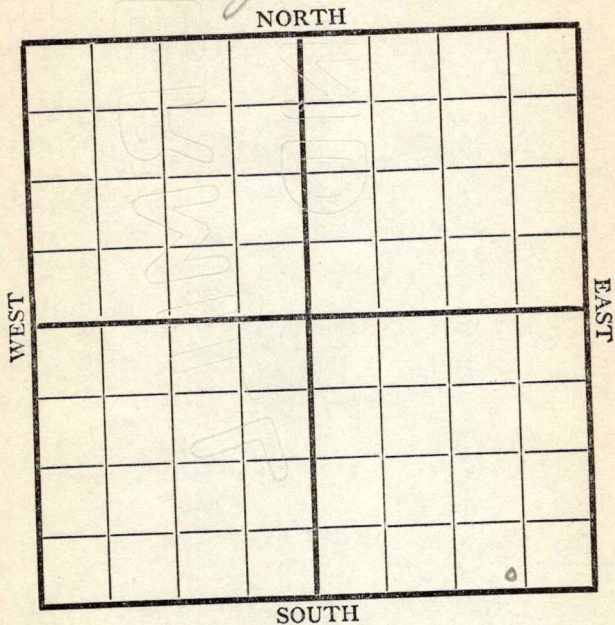

RECORD

Location _____

Cased _____ in., _____ ft.

Rig up _____

Sand _____

Drilling and Remarks:

Gas _____

Oil _____

Total Depth _____

2360

PRODUCTION

1st 24 hrs. Nat. _____

1st 24 hrs. after shot _____

Gas _____ Cu. Ft.

Dry Hole _____

Abandoned _____

Date

APR 3 1918

191


Condy Scout

Map No. _____ Sec. 3 Twp. 26 R. 4Well No. 5 Shriver FarmEngine Company

NORTH

WEST

EAST

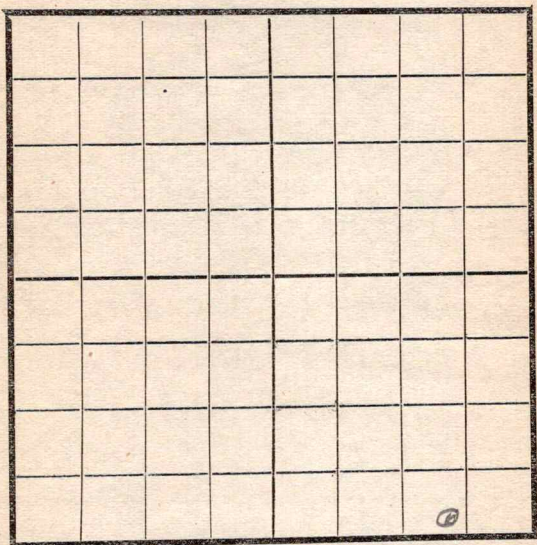

SOUTH

Location _____

Rig Up _____

Drilling and remarks

222360

RECORD

Cased _____ in. _____ Ft.

Sand _____

Gas _____

Oil _____

Total Depth _____

PRODUCTION

1st 24 hrs. Nat. _____

1st 24 hrs. after shot _____

Gas _____ Cu. Ft.

Dry Hole _____

Abandoned _____

Date

4/10, 1918 Condy Scout

Map No. _____ Sec. 3 Twp. 26 R. 4Well No. 5 Shriener Farm
Engine Company

NORTH

WEST

EAST

SOUTH

Location _____

Rig Up _____

Drilling and remarks

78-2385

RECORD

Cased _____ in. _____ Ft.

Sand _____

Gas _____

Oil _____

Total Depth _____

PRODUCTION

1st 24 hrs. Nat. _____

1st 24 hrs. after shot _____

Gas _____ Cu. Ft.

Dry Hole _____

Abandoned _____

Date

4/17, 1911 S. C. ... Scout

Map No. 1114 Sec. 3 Twp. 26 R. 4Well No. 5 Shriver FarmEngineering Company

NORTH

WEST



EAST

SOUTH

RECORD

Location -----

Cased ----- in. ----- Ft.

Rig Up -----

Sand 2385-2429

Drilling and remarks

Gas -----

Oil -----

Total Depth -----

PRODUCTION

1st 24 hrs. Nat. -----

1st 24 hrs. after shot -----

Gas ----- Cu. Ft.

Dry Hole -----

Abandoned -----

Date

4/24 1918 Conroy Scout