
Form 51—5M—9-28—27423

Map No. KANSAS Sec. 4 Twp. 23 S R. 2 E

Well No. 2 - Wetschensky Farm

Glasco Unit Company

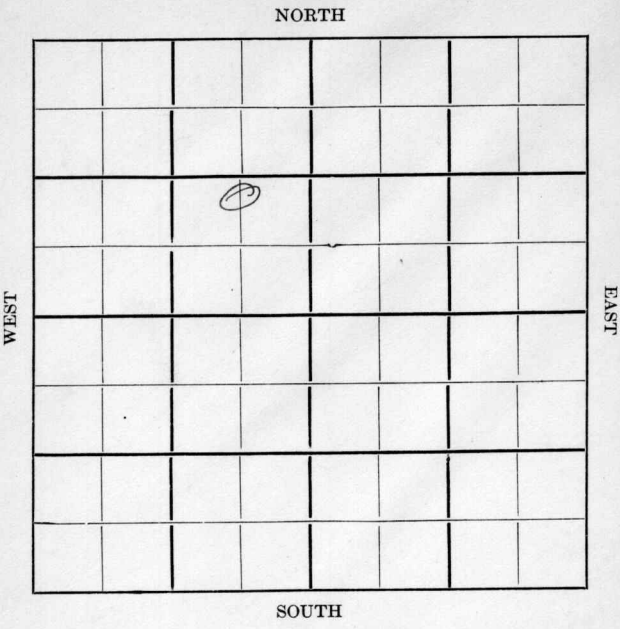

Location

Drilling Remarks

Rig Up

Drilling Remarks

RECORD

Cased ..... in. ..... ft.

Sand

Gas

Oil

Total Depth

PRODUCTION

1st 24 hrs. Nat.

1st 24 hrs. after shot

Gas ..... cu. ft.

Dry Hole


Abandoned

Form 252A—5M—5-28—Mid-West

Map No. ..... Sec. ..... Twp. ..... R. .....

Well No. ..... Farm

..... Company

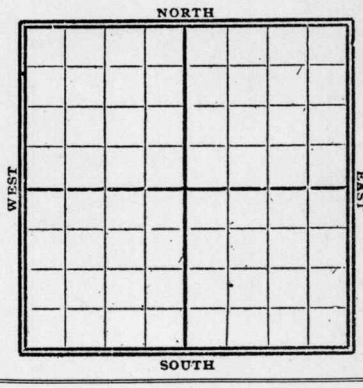

..... Ft. from N. Line

..... Ft. from S. Line

..... Ft. from E. Line

..... Ft. from W. Line

1922

Date	REPORT
	Gypsy Record
4/12	Rod TD 2470'

FORM 26 250 BKS. 4-28 WESTERN


MAP NO. K13 SEC. 4 TWP. 23S R. 7E

WELL NO. 2 Weschensky

Glasscock et al COMPANY

CONTRACTOR

SECTION PLAT

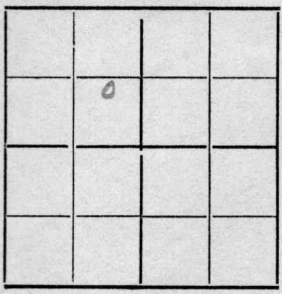

FT. FROM N. LINE

FT. FROM S. LINE

FT. FROM E. LINE

FT. FROM W. LINE

no Records

LOCATION

RIG UP

DRILLING AND REMARKS:

nothing in file

RECORD

CASED IN., FT.

SAND

GAS

OIL

TOTAL DEPTH 2470

PRODUCTION

1ST 24 HRS. NAT.

1ST 24 HRS. AFTER SHOT

GAS CU. FT.

DRY HOLE ✓

ABANDONED

DATE 4/12 192 2 SCOUT