


Map No. _____ Sec. 12 Twp. 26 L. 4Well No. 23 Enyart Farm __________Empire Company

NORTH

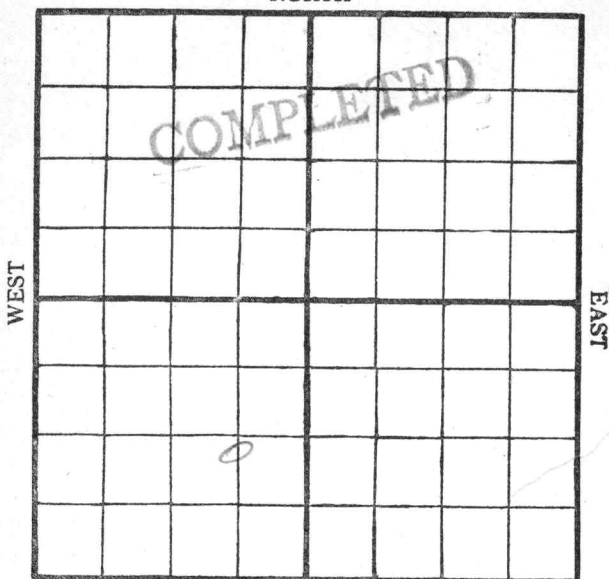

SOUTH

Location _____

Rig Up _____

Drilling Remarks:

400 Bacs (Land-2317-2339)5/22

Drilling Remarks:

RECORD

Cased _____ in. _____ ft.

Sand _____

Gas _____

Oil _____

Total Depth _____

PRODUCTION

1st 24 hrs. Nat. _____

1st 24 hrs. after shot _____

Gas _____ cu. ft


Dry Hole _____

Abandoned _____

Map No. K19 Sec. 12 Twp. 26 R. 4
 Well No. 238 Farm
Empire Gas & Fuel Company

NORTH

WEST

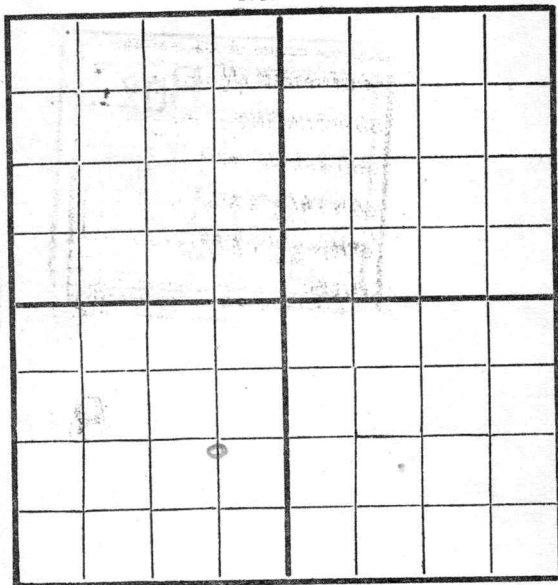

EAST

SOUTH

Location -----

Rig Up ☒ -----

Drilling and remarks -----

RECORD

Cased ----- in. ----- Ft.

Sand -----

Gas -----

Oil -----

Total Depth -----

PRODUCTION

1st 24 hrs. Nat. -----

1st 24 hrs. after shot -----

Gas ----- Cu. Ft.

Dry Hole -----

Abandoned -----

First Report

Date


1/2, 1918, Canada Scout

Map No. _____ Sec. 12 Twp. 26 R. 4Well No. 23 Farm _____

Company _____

NORTH

WEST

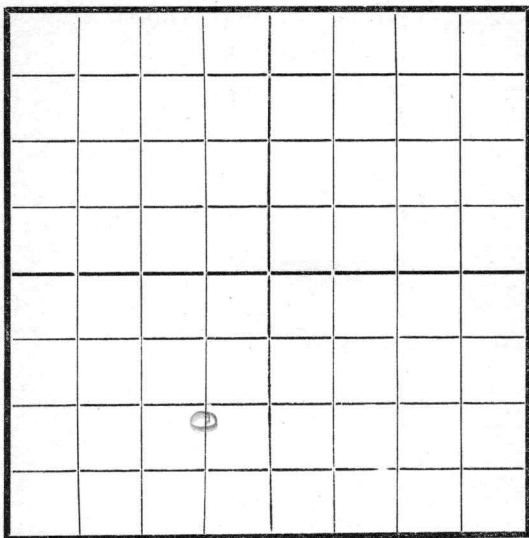

EAST

SOUTH

Location _____

Rig Up _____

Drilling and remarks

Rigging upWorce BrosE. J. Dond

RECORD

Cased _____ in. _____ Ft.

Sand _____

Gas _____

Oil _____

Total Depth _____

PRODUCTION

1st 24 hrs. Nat. _____

1st 24 hrs. after shot _____

Gas _____ Cu. Ft.

Dry Hole _____

Abandoned _____

Date

3/22, 1918 S. Condy Scout

Map No. _____ Sec. 12 Twp. 26 R. 4Well No. 23 _____

_____ Company

NORTH

WEST

EAST

SOUTH

Location _____

Rig up _____

Drilling and Remarks:

RECORD

Cased _____ in., _____ ft.

Sand _____

Gas _____

Oil _____

Total Depth _____

PRODUCTION

1st 24 hrs. Nat. _____

1st 24 hrs. after shot _____

Gas _____ Cu. Ft.

Dry Hole _____

Abandoned _____

Date

APR 3 1918 191. Scout


Map No. _____ Sec. 13 Twp. 26 R. 4

Well No. 23 August Farm _____

Engine Company _____

NORTH

WEST

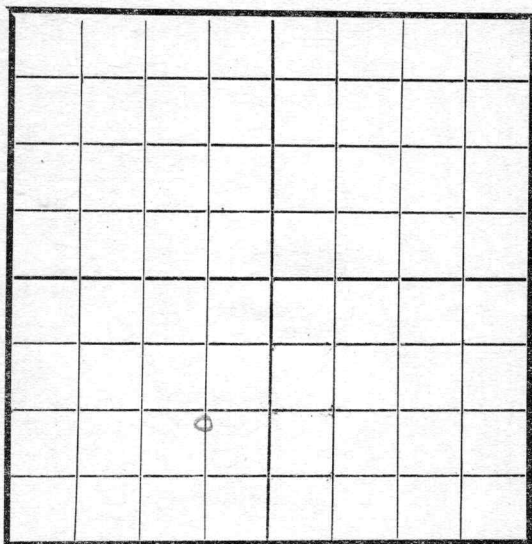

EAST

SOUTH

Location _____

Rig Up _____

Drilling and remarks

650

RECORD

Cased _____ in. _____ Ft.

Sand _____

Gas _____

Oil _____

Total Depth _____

PRODUCTION

1st 24 hrs. Nat. _____

1st 24 hrs. after shot _____

Gas _____ Cu. Ft.

Dry Hole _____

Abandoned _____

Date

4/10, 1918 S. C. Cuddy Scout

Map No. _____ Sec. 12 Twp. 26 R. 4


Well No. 23 Canyon Farm _____

Canyon Company _____

NORTH

WEST

EAST

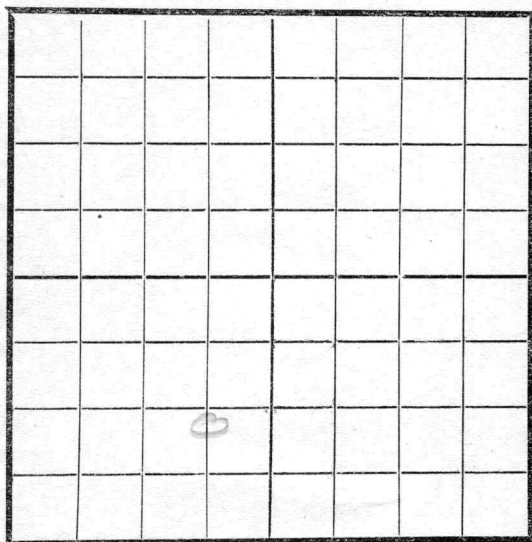

SOUTH

Location _____

Rig Up _____

Drilling and remarks

RECORD

Cased _____ in. _____ Ft.

Sand _____

Gas _____

Oil _____

Total Depth _____

PRODUCTION

1st 24 hrs. Nat. _____

1st 24 hrs. after shot _____

Gas _____ Cu. Ft.

Dry Hole _____


Abandoned _____

Date

4/17, 1918 S. Candy Scout

Map No. _____ Sec. 12 Twp. 26 R. 4
Well No. 23 Empire Farm _____
_____ Company

NORTH

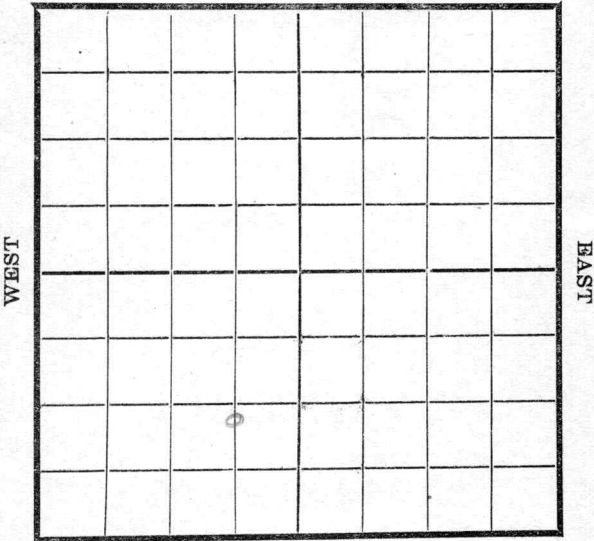

SOUTH

RECORD

Location _____
Rig Up _____
Drilling and remarks

Cased _____ in. _____ Ft.
Sand _____
Gas _____
Oil _____
Total Depth _____

1405

PRODUCTION


1st 24 hrs. Nat. _____
1st 24 hrs. after shot _____
Gas _____ Cu. Ft.
Dry Hole _____
Abandoned _____

Date 4/24, 1918 Empire Scout

Map No. _____ Sec. 12 Twp. 26 R. 4
Well No. 23 Canyon Farm _____
Canyon Company

NORTH

WEST

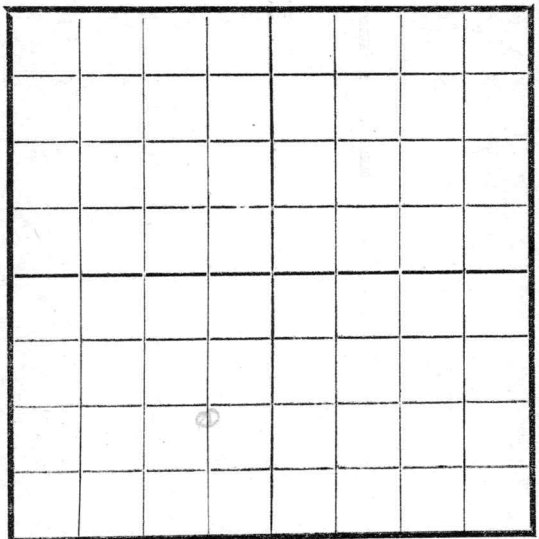

EAST

SOUTH

Location _____
Rig Up _____
Drilling and remarks _____

1810

RECORD

Cased _____ in _____ Ft
Sand _____
Gas _____
Oil _____
Total Depth _____

PRODUCTION

1st 24 hrs. Nat. _____
1st 24 hrs. after shot _____
Gas _____ Cu. Ft.
Dry Hole _____
Abandoned _____

Date


17, 1918 J. Canyon Scout

Map No. _____ Sec. 12 Twp. 26 R. 4Well No. 23 Empire Farm _____

Company _____

NORTH

WEST

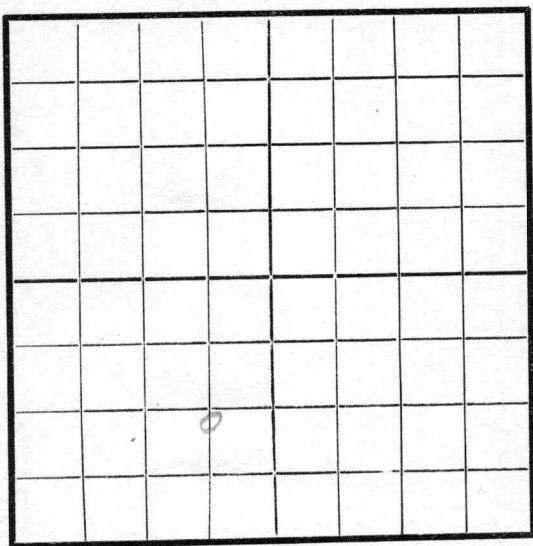

EAST

SOUTH

RECORD

Location _____

Cased _____ in. _____ Ft.

Rig Up _____

Sand _____

Drilling and remarks

Gas _____

Oil _____

Total Depth _____

2265

PRODUCTION

1st 24 hrs. Nat. _____

1st 24 hrs. after shot _____

Gas _____ Cu. Ft.

Dry Hole _____


Abandoned _____

Date

58, 1918 S. Conley Scout

Map No. _____ Sec. 12 Twp. 26 R. 4
Well No. 23 Canyon Farm _____
Canyon Company _____

NORTH

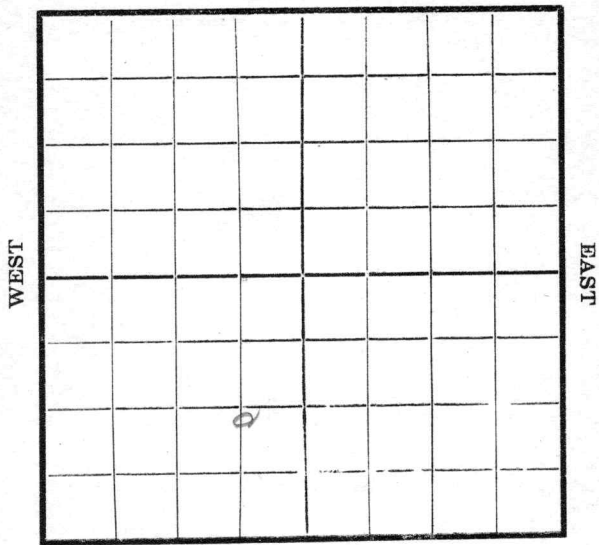

SOUTH

Location _____
Rig Up _____
Drilling and remarks _____

SD 2265

RECORD

Cased _____ in. _____ Ft.
Sand _____
Gas _____
Oil _____
Total Depth _____

PRODUCTION

1st 24 hrs. Nat. _____
1st 24 hrs. after shot _____
Gas _____ Cu. Ft.
Dry Hole _____
Abandoned _____


Date

7/15, 1918 S. Canyon Scout

Map No. 14 Sec. 12 Twp. 26 R. 4Well No. 23 Engineer FarmEngineer Company

NORTH

WEST

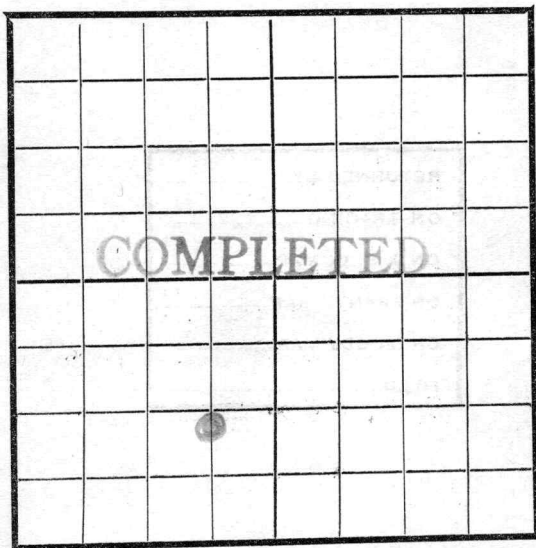

EAST

SOUTH

Location -----

Rig Up -----

Drilling and remarks

Est at
400 Bbls

RECORD

Cased ----- in. ----- Ft.

Sand 2317-2339

Gas -----

Oil -----

Total Depth -----

PRODUCTION

1st 24 hrs. Nat. -----

1st 24 hrs. after shot -----

Gas ----- Cu. Ft.

Dry Hole -----

Abandoned -----

Date

5/22, 1918 C. C. Cady Scout