


Section 3 Township 26 Range 4-E


Well No. 1 Schriver

Company Nat Wissman et al

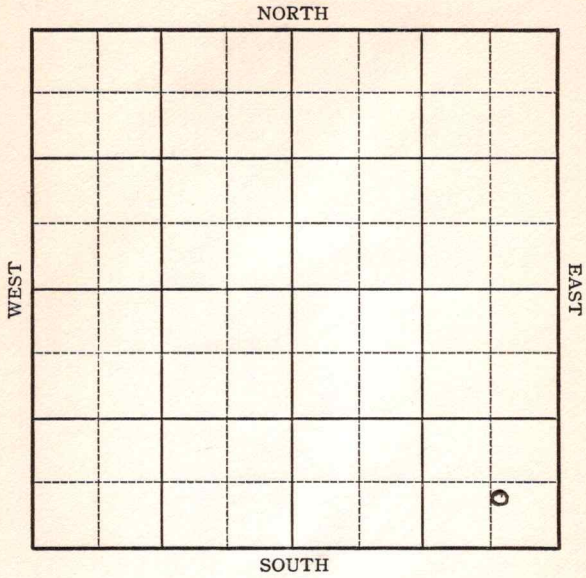

KANSAS

Butler

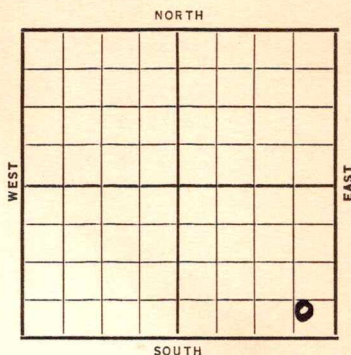Sec. 3 Twp. 26 R. 4-EWell No. #1 Schriver Farm
Nat Wissman et al Company Ft. from N. Line500 Ft. from S. Line600 Ft. from E. Line Ft. from W. Line

Date

REPORT

1937

11/3

5" @ 2406'.

Sil. 2404'.

T.D. 2427'.

1000 acid.

Potential 40 oil & 18 water.

FIRST REPORT

and
COMPLETED

Butler

KANSAS

Map No. 14 Sec. 3 Twp. 26 R4EWell No. 1 SchriverNat Wissman etal CompanyY ContractorFIRST REPORT
COMPLETED
SE/C

SECTION PLAT

			0

 Ft. from N. Line500 Ft. from S. Line600 Ft. from E. Line Ft. from W. LineLocation Rig up

Drilling and Remarks:

1000 AcidPOT 40 oil
18 wat.

RECORD

Cased 5 in., 2406 ft.Sand sil 2404Gas Oil Total Depth 2427

PRODUCTION

1st 24 hrs. Nat. 1st 24 hrs. after shot Gas Cu. Ft.Dry Hole Abandoned

Date

NOV 3 1937 19 H. D. Hatfield Scout