
Form 51—5-19—5M—Mid-West

Map No. K13 Sec. 4 Twp. 23 R. 2

Well No. 1 Wetschensky Farm

Watchorn et al Company

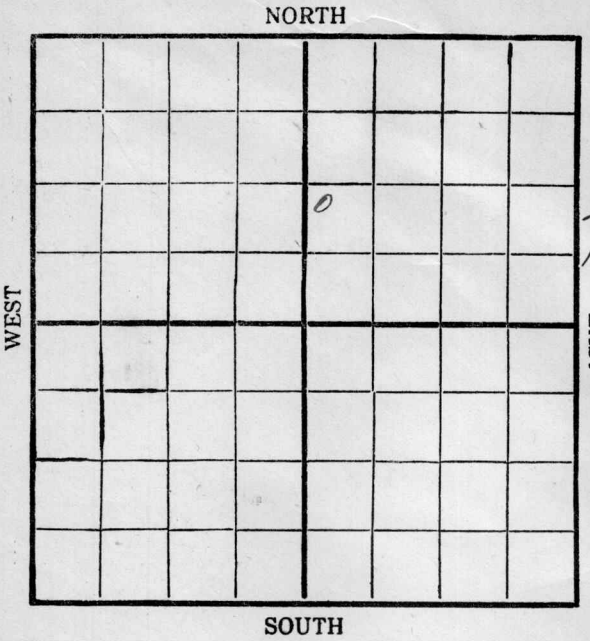

Location

Drilling Remarks:

Rig Up 8/17/19

Drilling Remarks:

COMPLETED

RECORD

Cased in. ft.

Sand

Gas

Oil

Total Depth

PRODUCTION

1st 24 hrs. Nat.

1st 24 hrs. after shot

Gas cu. ft.

Dry Hole

Abandoned

Form 252A 2M-9-19-CroMac.

Map No. _____ Sec. 4 Twp. 72 R. 2

Well No. L. Witschewsky Farm

Watcham et al Company

_____ Contractor


NE. Quarter

_____ Ft. from N. Lice

1120 Ft. from S. Line

_____ Ft. from E. Line

700 Ft. from W. Line

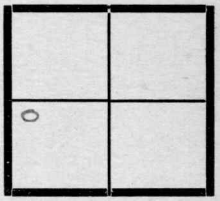

Date	REPORT
9/19	
10/13	LD 710
10/21	S.D. 710'
10/30	S.D. 710'
11/4	LD 710
12	LD 710 Tools moved out
18	LD 710'
25	S.D. 710'
12/1	LD 710
13	Shutdown 710'
15	S.D. 710'
22	" 710'
31	" "
13	SD 710'
19	" "
27	" "
1/2	" "
9	Shutdown 710'
1/15	Dry & cleaned 710

COMPLETED


Form 26—1M Books of 100 Sheets Each—4-15-18

Map No. K13 Sec. 4 Twp. 23 R. 2

Well No. 1 Yetsichenoky

Hatchorn et al. Company

Contractor

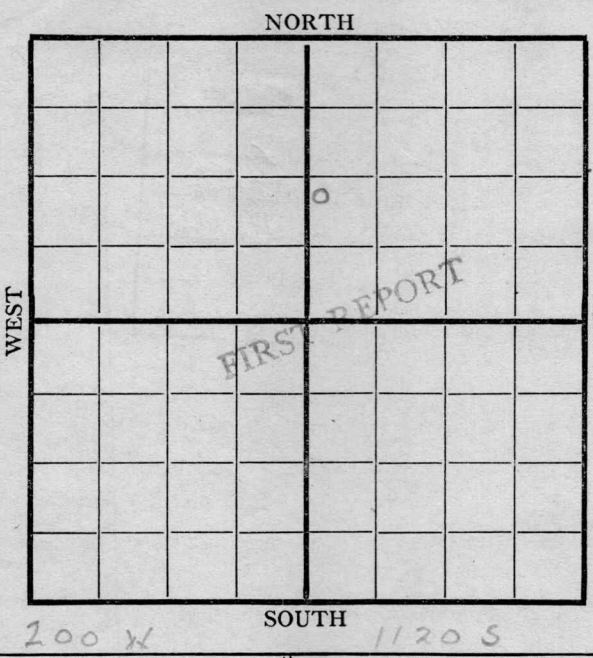

Location

Rig up ✓

Drilling and Remarks:

RECORD

Cased in., ft.

Sand

Gas

Oil

Total Depth

PRODUCTION

1st 24 hrs. Nat.

1st 24 hrs. after shot

Gas Cu. Ft.

Dry Hole

Abandoned

Date

8/12 1919. Cycle Scout

Form 26—1M—4-19—Mid-West


Map No. K13 Sec. 4 Twp. 23 R. 2 E

Well No. 1 Yetschensky

Watchorn et al Company

Contractor

SECTION PLAT

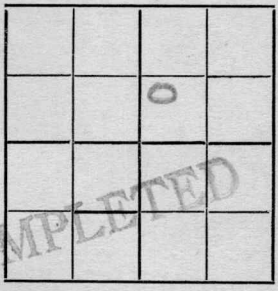

Ft. from N. Line

1120 Ft. from S. Line

Ft. from E. Line

200 Ft. from W. Line

COMPLETED

Location

Rig up

Drilling and Remarks:

RECORD

Cased in., ft.

Sand

Gas

Oil

Total Depth

PRODUCTION

1st 24 hrs. Nat.

1st 24 hrs. after shot

Gas Cu. Ft.

Dry Hole 1

Abandoned 710

Date

3/15 1920

Pyle Scout