


Map No. _____ Sec. 3 Twp. 26 R. 1

Well No. 7 Shiner Farm _____

Comprise Company _____

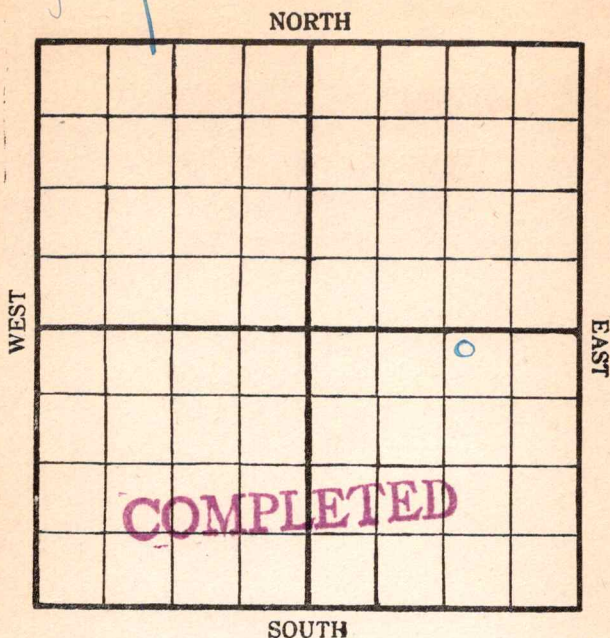

Location _____

Rig Up _____

Drilling Remarks:

Drilling Remarks:

RECORD

Cased _____ in. _____ ft.

Sand _____

Gas _____

Oil _____

Total Depth _____

PRODUCTION

1st 24 hrs. Nat. _____

1st 24 hrs. after shot _____

Gas _____ cu. ft.

Dry Hole _____

Abandoned _____

Form 26—1M Books of 100 Sheets Each.


Map No. 414 Sec. 3 Twp. 26 R. 4

Well No. 7 Shriver Farm

Engine Company

NORTH

WEST

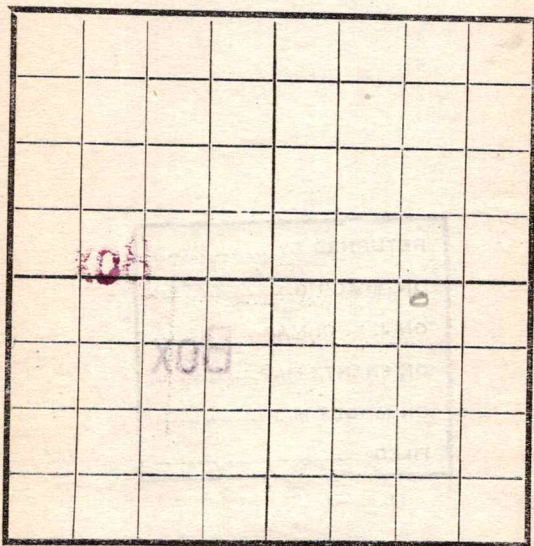

EAST

SOUTH

Location _____

Rig Up ☒ _____

Drilling and remarks _____

FIRST REPORT

RECORD

Cased _____ in. _____ Ft.

Sand _____

Gas _____

Oil _____

Total Depth _____

PRODUCTION

1st 24 hrs. Nat. _____

1st 24 hrs. after shot _____

Gas _____ Cu. Ft.

Dry Hole _____

Abandoned _____

Date

5/9, 1918 C. Condy Scout

Map No. _____ Sec. 6 Twp. 26 R. 4

Well No. 7 Skinner

Engineer _____ Company

Contractor

NORTH

WEST

EAST

SOUTH

Location _____

Rig up _____

Drilling and Remarks:

RECORD

Cased _____ in., _____ ft.

Sand

Gas -----

Oil _____

Total Depth.....

PRODUCTION

1st 24 hrs. Nat. -----

1st 24 hrs. after shot-----

Gas.....Cu. Ft.

Dry Hole.....

Abandoned.....

Date _____

6/26 1918 *Curry* Scout

Map No. _____ Sec. 3 Twp. 26 R. 4

Well No. 7 Kriscu

Company

Contractor

NORTH

WEST

EAST

SOUTH

Location _____

Rig up-----

Drilling and Remarks:

RECORD

Cased _____ in., _____ ft.

Sand_____

Gas _____

Oil_____

Total Depth_____

PRODUCTION

1st 24 hrs. Nat. -----

1st 24 hrs. after shot-----

Gas.....Cu. Ft.

Dry Hole.....

Abandoned.....

Date _____

191

Scout

Map No. _____ Sec. 3 Twp. 26 R. 4

Well No. 2 Shuman

Company

Contractor

NORTH

WEST

EAST

SOUTH

Location _____

Rig up-----

Drilling and Remarks:

RECORD

Cased-----in., -----ft.

Sand_____

Gas _____

Oil_____

Total Depth_____

PRODUCTION

1st 24 hrs. Nat. _____

1st 24 hrs. after shot-----

Gas.....Cu. Ft.

Dry Hole.....

Abandoned_____

Date _____

191

Scout

Map No. _____ Sec. 3 Twp. 26 R. 4Well No. 7 Schirer


_____ Company

_____ Contractor

NORTH

WEST

EAST

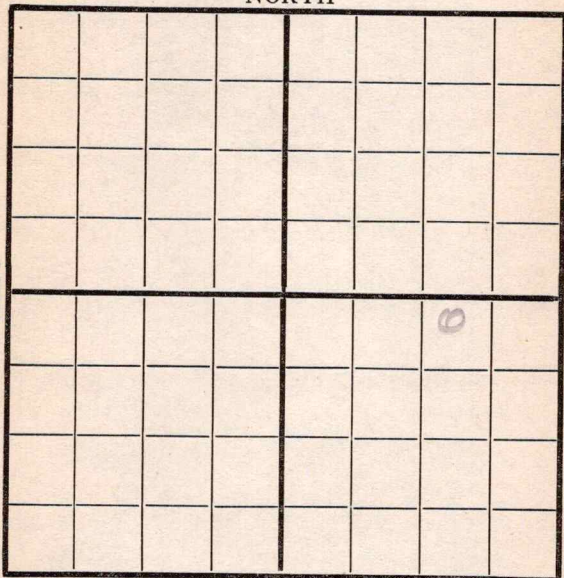

SOUTH

Location _____

Rig up _____

Drilling and Remarks:

RECORD

Cased _____ in., _____ ft.

Sand _____

Gas _____

Oil _____

Total Depth _____

PRODUCTION

1st 24 hrs. Nat. _____

1st 24 hrs. after shot _____

Gas _____ Cu. Ft.

Dry Hole _____

Abandoned _____

Date

7/17 191 S. Condy Scout

Map No. _____ Sec. 3 Twp. 26 R. 4

Well No. 25

Company

Contractor

Contractor
El Dorado NORTH

WEST

EAST

NORTH

SOUTH

Location _____

Rig up-----

Drilling and Remarks:

225

RECORD

Cased-----in., -----ft.

Sand _____

Gas -----

Oil _____

Total Depth_____

PRODUCTION

1st 24 hrs. Nat. -----

1st 24 hrs. after shot-----

Gas.....Cu. Ft.

Dry Hole.....

Abandoned.....

Date _____

7/24 1918 Scout

Map No. _____ Sec. 3 Twp. 26 R. 4

Well No. 7 Skriver

Empire

Company

Contractor

NORTH

WEST

EAST

SOUTH

RECORD

Location _____

Rig up-----

Drilling and Remarks:

730

Cased-----in., -----ft.

Sand.....

Gas _____

Oil _____

Total Depth_____

PRODUCTION

1st 24 hrs. Nat. -----

1st 24 hrs. after shot_____

Gas.....Cu. Ft.

Dry Hole

Abandoned.....

Date _____

7/31 191 P P *[Signature]* Scout

Map No. _____ Sec. 3 Twp. 26 R. 4Well No. 7 Shiner


_____ Company

_____ Contractor

NORTH

WEST

EAST

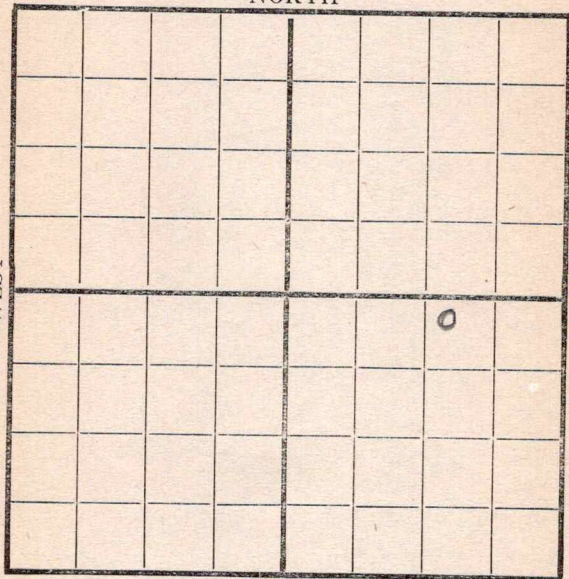

SOUTH

Location 200 N 1120 E

Rig up _____

Drilling and Remarks:

1100

RECORD

Cased _____ in., _____ ft.

Sand _____

Gas _____

Oil _____

Total Depth _____

PRODUCTION

1st 24 hrs. Nat. _____

1st 24 hrs. after shot _____

Gas _____ Cu. Ft.

Dry Hole _____

Abandoned _____

Date

8/2

191

S. Condy


Scout

Map No. _____ Sec. 3 Twp. 26 R. 4

Well No. 7 Skinner

_____ Company

_____ Contractor

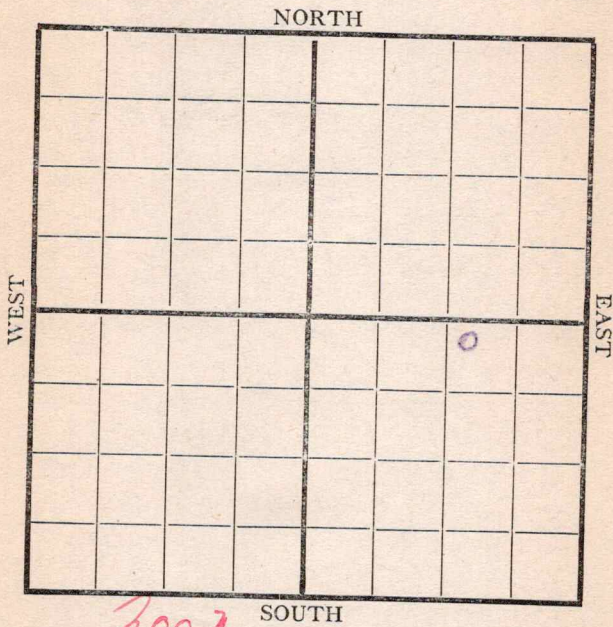

2007

Location 11206

Rig up _____

Drilling and Remarks:

1425'

RECORD

Cased _____ in., _____ ft.

Sand _____

Gas _____

Oil _____

Total Depth _____

PRODUCTION

1st 24 hrs. Nat. _____

1st 24 hrs. after shot _____

Gas _____ Cu. Ft.

Dry Hole _____

Abandoned _____

Date

8/5 1918

Cyle

Scout

Map No. _____ Sec. 3 Twp. 26 R. 4

Well No. 7 Shivers


_____ Company

_____ Contractor

NORTH

WEST

EAST

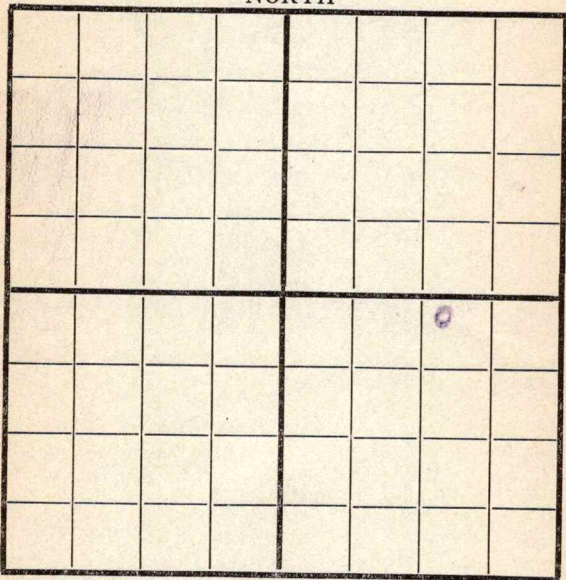

SOUTH

200' N - 1120' E

Location _____

Rig up _____

Drilling and Remarks:

1920'

RECORD

Cased _____ in., _____ ft.

Sand _____

Gas _____

Oil _____

Total Depth _____

PRODUCTION

1st 24 hrs. Nat. _____

1st 24 hrs. after shot _____

Gas _____ Cu. Ft.

Dry Hole _____

Abandoned _____

Date

8/22 1918

Pyle

Scout

Map No. 1514 Sec. 3 Twp. 26 R. 4

Well No. 7 Skriver

Company

Contractor

NORTH

WEST

EAST

SOUTH

Location _____

Rig up-----

Drilling and Remarks:

RECORD

Cased-----in., -----ft.

Sand_____

Gas _____

Oil _____

Total Depth_____

PRODUCTION

1st 24 hrs. Nat. -----

1st 24 hrs. after shot-----

Gas.....Cu. Ft.

Dry Hole.....

Abandoned.....

Date _____

191


Scout

Map No. 1514 Sec. 3 Twp. 26 R. 4

Well No. 7 Shivers

_____ Company

_____ Contractor

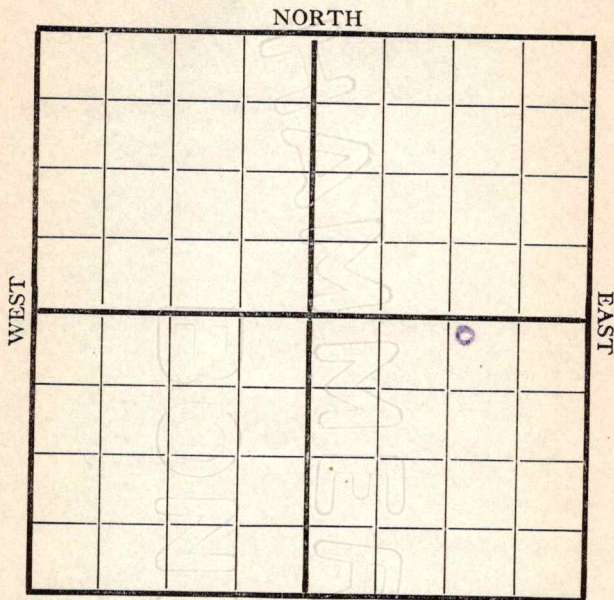

Location _____

Rig up _____

Drilling and Remarks:

2385

RECORD

Cased _____ in., _____ ft.

Sand _____

Gas _____

Oil _____

Total Depth _____

PRODUCTION

1st 24 hrs. Nat. _____

1st 24 hrs. after shot _____

Gas _____ Cu. Ft.

Dry Hole _____

Abandoned _____

Date

9/4

191

J. C. Cardy


Scout

Map No. K14 Sec. 3 Twp. 26 R. 4Well No. 7 Shiner
Engine Company
Contractor

NORTH

WEST

EAST

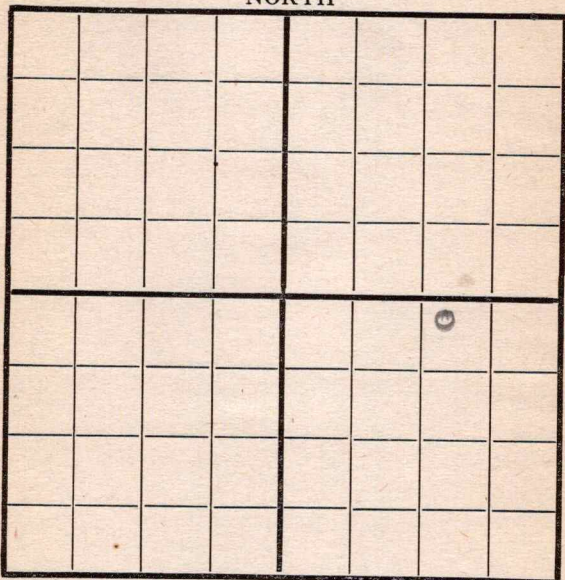

200 N - 1120 E SOUTH

Location _____

Rig up _____

Drilling and Remarks:

T.S.

2392

RECORD

Cased _____ in., _____ ft.

Sand _____

Gas _____

Oil _____

Total Depth _____

PRODUCTION

1st 24 hrs. Nat. _____

1st 24 hrs. after shot _____

Gas _____ Cu. Ft.

Dry Hole _____

Abandoned _____

Date

9/11 191 P. Conroy Scout

Map No. K14 Sec. 3 Twp. 26 R. 4

Well No. 7 Shriver Farm
Empire Company

NORTH

WEST

EAST

COMPLETED

SOUTH

200 ft - 1100 E

Location _____

Rig up _____

Drilling and remarks:

Est at
80 Bbl

RECORD

Cased _____ in. _____ Ft.

Sand 2392-2446

Gas _____

Oil _____

Total Depth _____

PRODUCTION

1st 24 hrs. Nat. _____

1st 24 hrs. after shot _____

Gas _____ Cu. Ft.

Dry Hole _____

Abandoned _____

Date

9/18, 1918, Cord Scout