

Map No. 68 Sec. 3 Twp. 26 R. 4

Well No. 6 in fire Farm _____

Company _____

NORTH

WEST

EAST



SOUTH

Location _____

Rig Up _____

Drilling Remarks:

Drilling Remarks:

RECORD

PRODUCTION

Cased _____ in. _____ ft.

1st 24 hrs. Nat. _____

Sand _____

1st 24 hrs. after shot _____

Gas _____

Gas _____ cu. ft.

Oil _____

Dry Hole _____

Total Depth _____

Abandoned _____

Map No. _____ Sec. 3 Twp. 26 R. 4Well No. 8 Shriver_____Engine_____
Company_____
Contractor

NORTH

WEST

EAST

SOUTH

Location _____

Rig up _____

Drilling and Remarks:

RECORD

Cased _____ in., _____ ft.

Sand _____

Gas _____

Oil _____

Total Depth _____

PRODUCTION

1st 24 hrs. Nat. _____

1st 24 hrs. after shot _____

Gas _____ Cu. Ft.

Dry Hole _____

Abandoned _____

Date

3/26 191 8 Coudy Scout

Company

Contractor

WEST

EAST

SOUTH

RECORD

Location _____

Cased _____ in., _____ ft.

Rig up _____

Sand_____

Drilling and Remarks:

Gas

Oil_____

Total Depth_____

PRODUCTION

1st 24 hrs. Nat. _____

1st 24 hrs. after shot_____

Gas.....Cu. Ft.

Dry Hole.....

Abandoned.....

Date _____

191

Scout

Map No. _____ Sec. 3 Twp. 26 R. 4Well No. 8 Shriners
Engine Company

Contractor _____

NORTH

WEST

EAST

SOUTH

Location _____

Rig up ☒

Drilling and Remarks:

RECORD

Cased _____ in., _____ ft.

Sand _____

Gas _____

Oil _____

Total Depth _____

PRODUCTION

1st 24 hrs. Nat. _____

1st 24 hrs. after shot _____

Gas _____ Cu. Ft.

Dry Hole _____

Abandoned _____

Date

2/17 191 8 Condy Scout

Map No. _____ Sec. _____ Twp. 26 R. 9

Well No. 8 Shree

Company

Contractor

NORTH

WEST

EAST

SOUTH

Location _____

Rig up-----

Drilling and Remarks:

Spinning

RECORD

Cased _____ in., _____ ft.

Sand _____

Gas

Oil _____

Total Depth_____

PRODUCTION

1st 24 hrs. Nat. -----

1st 24 hrs. after shot-----

Gas.....Cu. Ft.

Dry Hole.....

Abandoned.....

Date _____


7/24 1918 *8 Caring*

Scout

Map No. _____ Sec. 3 Twp. 26 R. 4

Well No. 8 Shriver
E. Empire Company
 _____ Contractor

NORTH

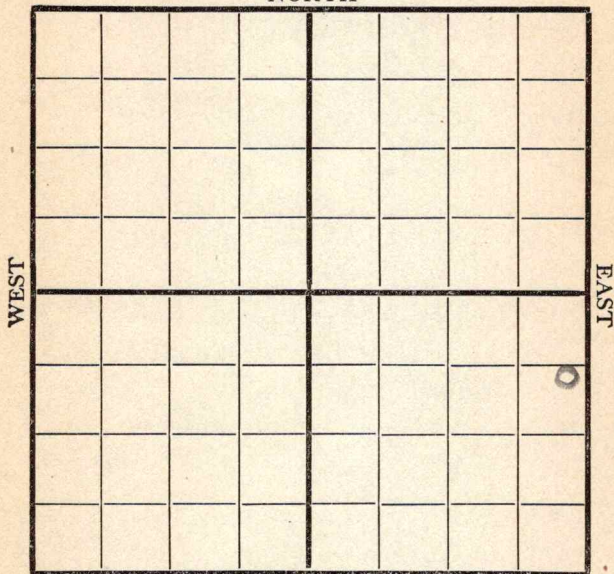

SOUTH

700' ~~24~~ x 24 x 200 ~~14~~ 18

Location _____

Rig up _____

Drilling and Remarks:

745

RECORD

Cased _____ in., _____ ft.

Sand _____

Gas _____

Oil _____

Total Depth _____

PRODUCTION

1st 24 hrs. Nat. _____

1st 24 hrs. after shot _____

Gas _____ Cu. Ft.

Dry Hole _____

Abandoned _____

Date

7/31 1918 8 E. Empire Scout


Map No. _____ Sec. 3 Twp. 26 R. 4Well No. 8 ShinerEngine Company

Contractor _____

NORTH

WEST

EAST

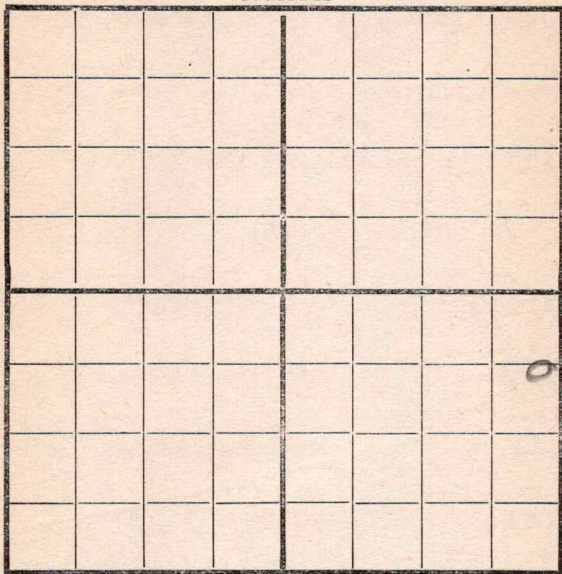

SOUTH

Location 700 N
200 E

Rig up _____

Drilling and Remarks:

1440

RECORD

Cased _____ in., _____ ft.

Sand _____

Gas _____

Oil _____

Total Depth _____

PRODUCTION

1st 24 hrs. Nat. _____

1st 24 hrs. after shot _____

Gas _____ Cu. Ft.

Dry Hole _____

Abandoned _____

Date

8/7

191

P. Candy

Scout

Map No. _____ Sec. 3 Twp. 26 R. 4Well No. 8 Skinner


_____ Company

_____ Contractor

NORTH

WEST

EAST

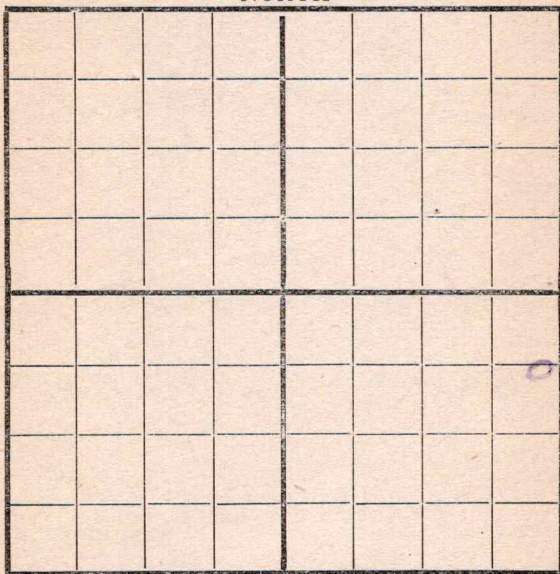

SOUTH

Location 700 N
200 E

Rig up _____

Drilling and Remarks:

1585'

RECORD

Cased _____ in., _____ ft.

Sand _____

Gas _____

Oil _____

Total Depth _____

PRODUCTION

1st 24 hrs. Nat. _____

1st 24 hrs. after shot _____

Gas _____ Cu. Ft.

Dry Hole _____

Abandoned _____

Date

7/15 1918Cryh Scout


Map No. _____ Sec. 3 Twp. 26 R. 4

Well No. 8 Shiner

E. M. M. Co. Company

Contractor

NORTH

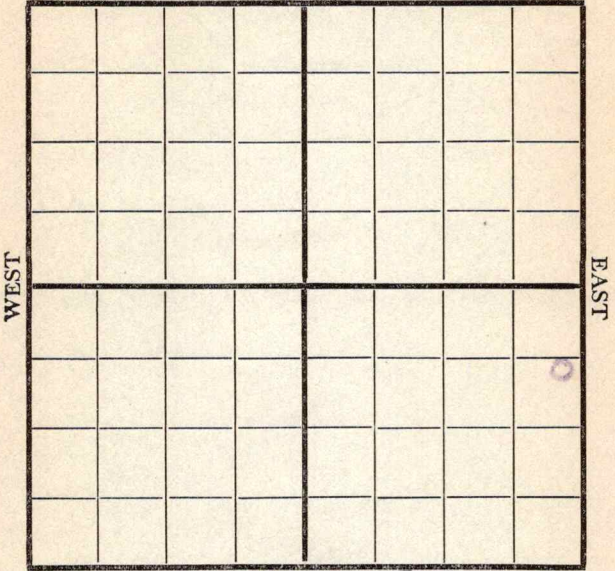

SOUTH

200' N - 200' E

Location _____

Rig up _____

Drilling and Remarks:

2080'

RECORD

Cased _____ in., _____ ft.

Sand _____

Gas _____

Oil _____

Total Depth _____

PRODUCTION

1st 24 hrs. Nat. _____

1st 24 hrs. after shot _____

Gas _____ Cu. Ft.

Dry Hole _____

Abandoned _____

Date

8/22

1918

Pyle

Scout

Map No. 1514 Sec. 3 Twp. 36 R. 4

Well No. 8 Shrim


Engine Company

Contractor

NORTH

WEST

EAST

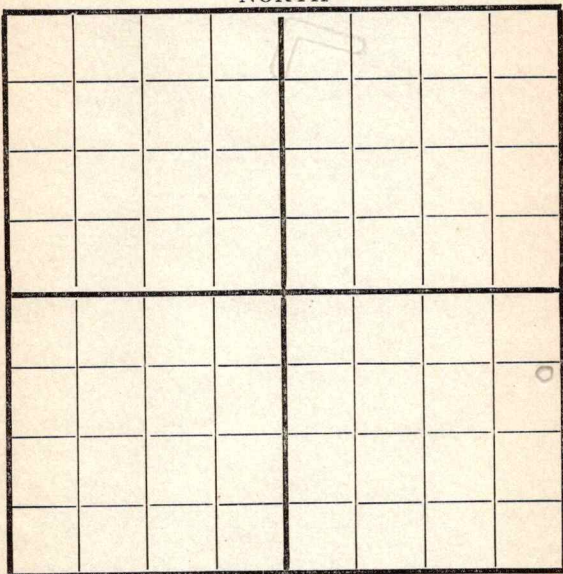

SOUTH

Location _____

Rig up _____

Drilling and Remarks:

2250

RECORD

Cased _____ in., _____ ft.

Sand _____

Gas _____

Oil _____

Total Depth _____

PRODUCTION

1st 24 hrs. Nat. _____

1st 24 hrs. after shot _____

Gas _____ Cu. Ft.

Dry Hole _____

Abandoned _____

Date

8/28 191 8 C. C. C. Scout


Map No. 1514 Sec. 3 Twp. 26 R. 4Well No. 8 ShriverEngine Company

Contractor

NORTH

WEST

EAST

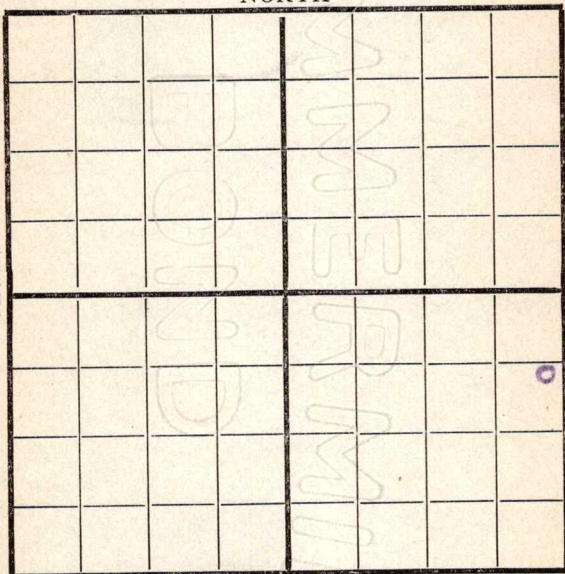

SOUTH

Location -----

Rig up -----

Drilling and Remarks:

2390

RECORD

Cased ----- in., ----- ft.

Sand -----

Gas -----

Oil -----

Total Depth -----

PRODUCTION

1st 24 hrs. Nat. -----

1st 24 hrs. after shot -----

Gas ----- Cu. Ft.

Dry Hole -----

Abandoned -----

Date

9/4

191

J. C. Card

Scout

Map No. K14 Sec. 3 Twp. 26 R. 4Well No. 8 Shriver
Engine Company _____ Contractor _____

NORTH

WEST

COMPLETED

EAST

700 N 200 E SOUTH

Location _____

Rig up _____

Drilling and Remarks:

Est at
60 Bbl.

RECORD

Cased _____ in., _____ ft.

Sand 7387-2439

Gas _____

Oil _____

Total Depth _____

PRODUCTION

1st 24 hrs. Nat. _____

1st 24 hrs. after shot _____

Gas _____ Cu. Ft.

Dry Hole _____

Abandoned _____

Date

9/11 191 Scout