

Map No. 9 Sec. 3 Twp. 26 R. 1


Well No. 6 m fire Farm _____

Company _____

NORTH

WEST

EAST

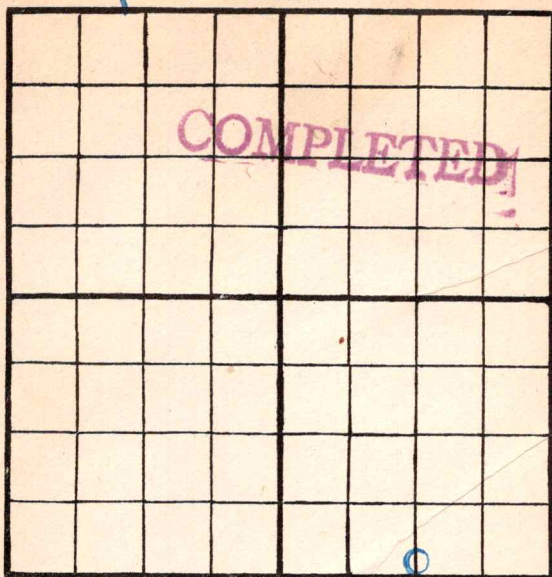

SOUTH

Location _____

Rig Up _____

Drilling Remarks:

Drilling Remarks:

RECORD

PRODUCTION

Cased _____ in. _____ ft.

1st 24 hrs. Nat. _____

Sand _____

1st 24 hrs. after shot _____

Gas _____

Gas _____ cu. ft.

Oil _____

Dry Hole _____

Total Depth _____

Abandoned _____

Map No. K14 Sec. 3 Twp. 26 R. 4
 Well No. 9 Shreve
Empire Company
 Contractor

NORTH							
WEST							
SOUTH							
EAST							

Location _____

Rig up _____

Drilling and Remarks:

RECORD

Cased _____ in., _____ ft.

Sand _____

Gas _____

Oil _____

Total Depth _____

PRODUCTION

1st 24 hrs. Nat. _____

1st 24 hrs. after shot _____

Gas _____ Cu. Ft.

Dry Hole _____

Abandoned _____


Date

4/13 1918 C. C. Cady Scout

Map No. _____ Sec. 3 Twp. 36 R. 4

Well No. 9 Shriver Farm _____
Empire Company

Harbert Williams - Eldorado NORTH

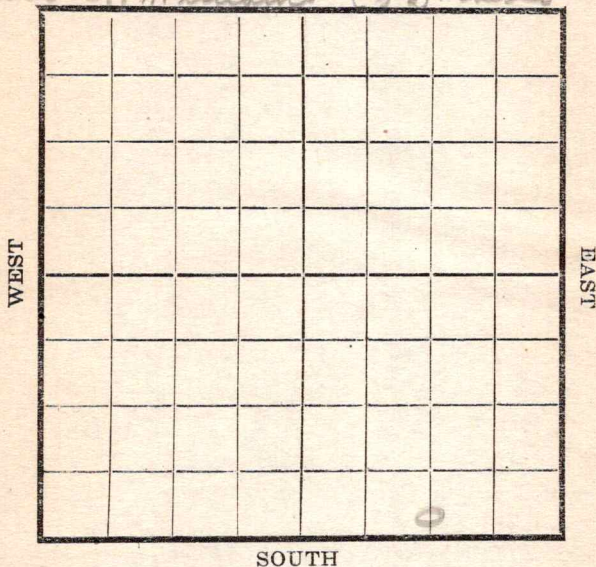

Location _____
 Rig Up _____
 Drilling and remarks

225

RECORD


Cased _____ in. _____ Ft.
 Sand _____
 Gas _____
 Oil _____
 Total Depth _____

PRODUCTION

1st 24 hrs. Nat. _____
 1st 24 hrs. after shot _____
 Gas _____ Cu. Ft.
 Dry Hole _____
 Abandoned _____

Date

6/19, 1918 Carry Scout

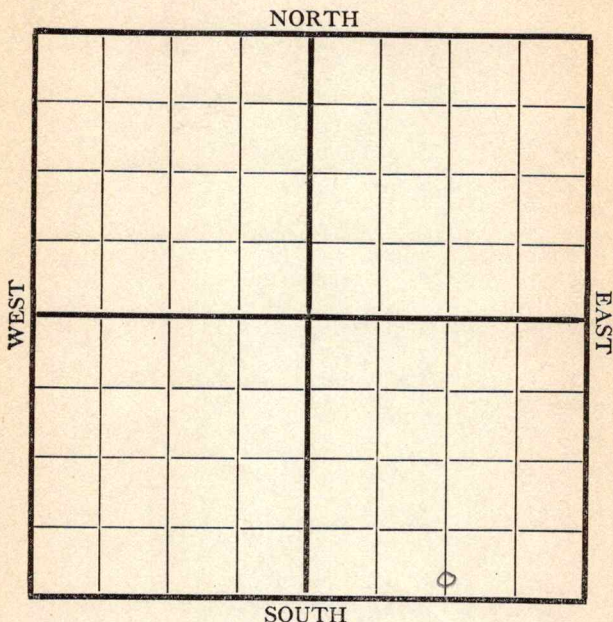Map No. _____ Sec. 3 Twp. 26 R. 4Well No. 9 S River_____
Empire Company_____
Contractor

Location _____

Rig up _____

Drilling and Remarks:

800**RECORD**

Cased _____ in., _____ ft.

Sand _____

Gas _____

Oil _____

Total Depth _____

PRODUCTION

1st 24 hrs. Nat. _____

1st 24 hrs. after shot _____

Gas _____ Cu. Ft.

Dry Hole _____

Abandoned _____

Date

6/26 1918 Candys Scout


Map No. _____ Sec. 3 Twp. 26 R. 4Well No. 9 Shriver

_____ Company

_____ Contractor

NORTH

WEST

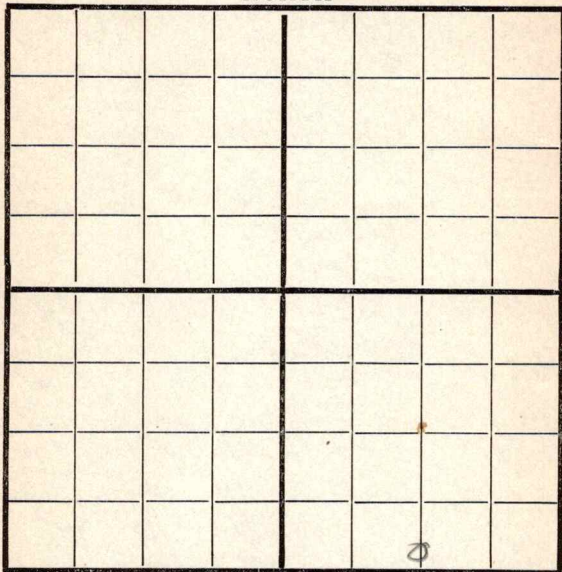

EAST

SOUTH

RECORD

Location _____

Cased _____ in., _____ ft.

Rig up _____

Sand _____

Drilling and Remarks:

Gas _____

Oil _____

Total Depth _____

PRODUCTION

1st 24 hrs. Nat. _____

1st 24 hrs. after shot _____

Gas _____ Cu. Ft.

Dry Hole _____

Abandoned _____

Date

7/3 191 J. Condeff Scout

Map No. _____ Sec. 3 Twp. 26 R. 4Well No. 9 Shriser

_____ Company

_____ Contractor

NORTH

WEST

EAST

SOUTH

Location _____

Rig up _____

Drilling and Remarks:

1635

RECORD

Cased _____ in., _____ ft.

Sand _____

Gas _____

Oil _____

Total Depth _____

PRODUCTION

1st 24 hrs. Nat. _____

1st 24 hrs. after shot _____

Gas _____ Cu. Ft.

Dry Hole _____

Abandoned _____

Date

7/10 191 S. Condy Scout

Map No. _____ Sec. 3 Twp. 26 R. 4Well No. 9 Shriener

_____ Company

_____ Contractor

NORTH

WEST

EAST

SOUTH

Location _____

Rig up _____

Drilling and Remarks:

1635

RECORD

Cased _____ in., _____ ft.

Sand _____

Gas _____

Oil _____

Total Depth _____

PRODUCTION

1st 24 hrs. Nat. _____

1st 24 hrs. after shot _____

Gas _____ Cu. Ft.

Dry Hole _____

Abandoned _____

Date

7/101918C. Conley

Scout

Map No. _____ Sec. 3 Twp. 26 R. 4

Well No. 9 Shrin

_____ Company

_____ Contractor

NORTH

WEST

EAST

SOUTH

Location _____

Rig up _____

Drilling and Remarks:

Shut Down
1635

RECORD

Cased _____ in., _____ ft.

Sand _____

Gas _____

Oil _____

Total Depth _____

PRODUCTION

1st 24 hrs. Nat. _____

1st 24 hrs. after shot _____

Gas _____ Cu. Ft.

Dry Hole _____

Abandoned _____

Date

7/17 1918 *Scout*

Map No. _____ Sec. 3 Twp. 26 R. 4Well No. 9 _____

_____ Company

_____ Contractor

NORTH

WEST

EAST

SOUTH

Location _____

Rig up _____

Drilling and Remarks:

Shut down1635

RECORD

Cased _____ in., _____ ft.

Sand _____

Gas _____

Oil _____

Total Depth _____

PRODUCTION

1st 24 hrs. Nat. _____

1st 24 hrs. after shot _____

Gas _____ Cu. Ft.

Dry Hole _____

Abandoned _____

Date

7/241918S. Conroy

Scout


Map No. _____ Sec. 3 Twp. 26 R. 4Well No. 9 ShriverEngine Company

Contractor _____

NORTH

WEST

EAST

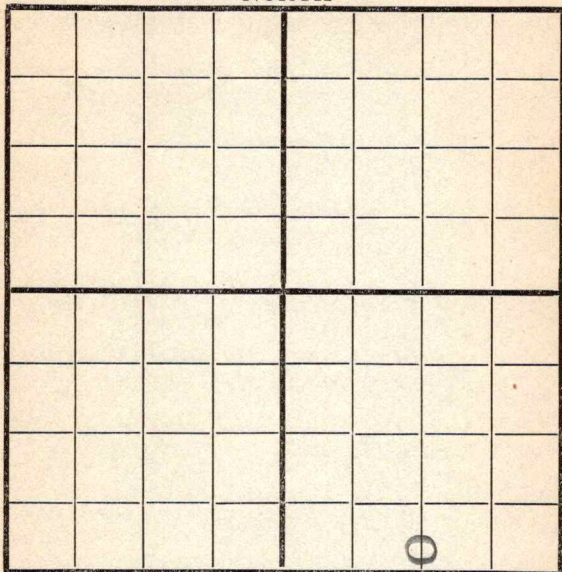

SOUTH

2004 ~~SL~~ 1320 ~~SL~~ EL

Location _____

Rig up _____

Drilling and Remarks:

2040

RECORD

Cased _____ in., _____ ft.

Sand _____

Gas _____

Oil _____

Total Depth _____

PRODUCTION

1st 24 hrs. Nat. _____

1st 24 hrs. after shot _____

Gas _____ Cu. Ft.

Dry Hole _____

Abandoned _____

Date


7/31 191 8. Condy Scout

Map No. _____ Sec. 3 Twp. 26 R. 4Well No. 9 S. 1/2 Sec. 3 Twp. 26 R. 4_____
Company_____
Contractor

NORTH

WEST

EAST

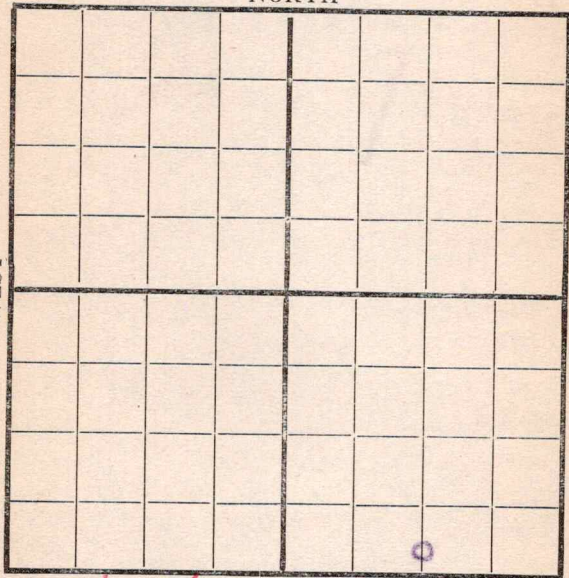

SOUTH

Location 200 S 13206

Rig up _____

Drilling and Remarks:

2380'

RECORD

Cased _____ in., _____ ft.

Sand _____

Gas _____

Oil _____

Total Depth _____

PRODUCTION

1st 24 hrs. Nat. _____

1st 24 hrs. after shot _____

Gas _____ Cu. Ft.

Dry Hole _____

Abandoned _____

Date

8/1

191

Oyle


Scout

Map No. K14 Sec. 3 Twp. 26 R. 24

Well No. 9 Shriver

Empire Company

Contractor

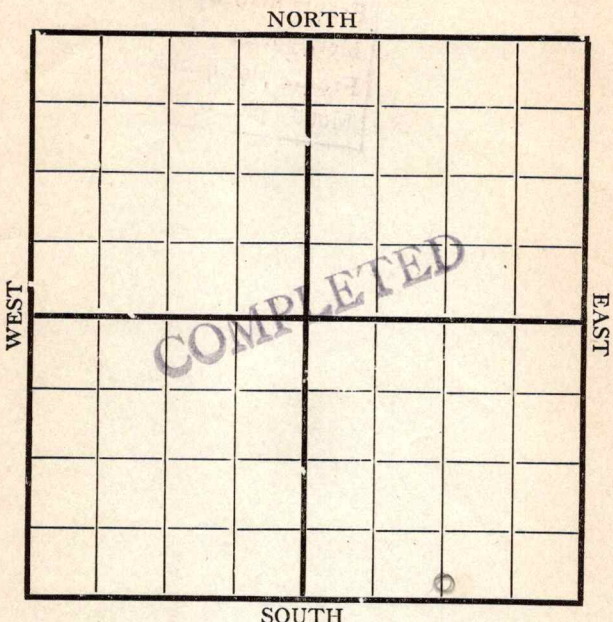

200' D-1370' E.
Location

Rig up

Drilling and Remarks:

RECORD

Cased _____ in., _____ ft.

Sand 2383-2435

Gas _____

Oil _____

Total Depth _____

PRODUCTION

1st 24 hrs. Nat. 120 bbls

1st 24 hrs. after shot _____

Gas _____ Cu. Ft.

Dry Hole _____

Abandoned _____

Date

8/20 1918 Coyne Scout