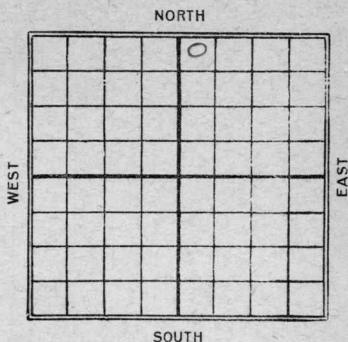


Abandoned

Map No. 15 Sec. 1 Twp. 23 R. 9Well No. #1 Hartley Farm
Caldwell Company200 Ft. from N. Line

Ft. from S. Line

Ft. from E. Line

200 Ft. from W. Line

C.

Date	REPORT
1924	
11/19	Timbers
11/26	Rig & Tools
12/17	S.D. 730'
1925	
1/21	Dlg 900'
1/25	2494-2506 T.D. 2528
5/29	P.B. to 2506 shot 80 gts
	Pumped 17 Bbls 5 and 3 Bbls
	Shut down, Well dull
	deepen
6/5	2494-2506 T.D. 2528
	P.B. to 2506 shot 80 gts
	made 17 Bbls 3 Bbls &
	5 Bbls S.D. Well dull
	deepen
6/12	
6/19	Dlg by tools T.D. 2528
6/26	S.D. T.D. 2528
7/3	2494-2506 - TD 2528
	Alba. & plugged shot 80 gts

15 KANSAS
 Map No. _____ Sec. _____ Twp. 23 R. 9

Well No. #1 Hartley _____

Caldwell _____ Company

_____ Contractor

FIRST REPORT

200' _____ Ft. from N. Line

_____ Ft. from S. Line

_____ Ft. from E. Line

200' _____ Ft. from W. Line

SECTION PLAT

		0	

Location _____

Rig up _____

Drilling and Remarks:

Timbers

RECORD

Cased _____ in., _____ ft.

Sand _____

Gas _____

Oil _____

Total Depth _____

PRODUCTION

1st 24 hrs. Nat. _____

1st 24 hrs. after shot _____

Gas _____ Cu. Ft.

Dry Hole _____

Abandoned _____

Date NOV 19 1924

M. A. BENEAR

_____ 192 _____

_____ Scout

Map No. 151444 Sec. 1 Twp. 23 R. 9Well No. 1 Hartby
Caldwell Company

Contractor

COMPLETED

SECTION PLAT

200 Ft. from N. Line

Ft. from S. Line

Ft. from E. Line

200 Ft. from W. Line

ABANDONED

		0	

Location

Rig up

Drilling and Remarks:

80' Small Show
100'
Plugged & abandoned
20 2528'

RECORD

Cased _____ in., _____ ft.

Sand 2494 - 2506

Gas _____

Oil _____

Total Depth 2528

PRODUCTION

1st 24 hrs. Nat. _____

1st 24 hrs. after shot _____

Gas _____ Cu. Ft.

Dry Hole _____

Abandoned _____

Date

JUL 3 1925

CHAS. L. SHERWOOD

192

Scout