

Map No. _____ Sec. 3 Twp. 26 R. 4


Well No. 10 Shriper Farm _____

Empire Gas Co. Company _____

NORTH

WEST

EAST

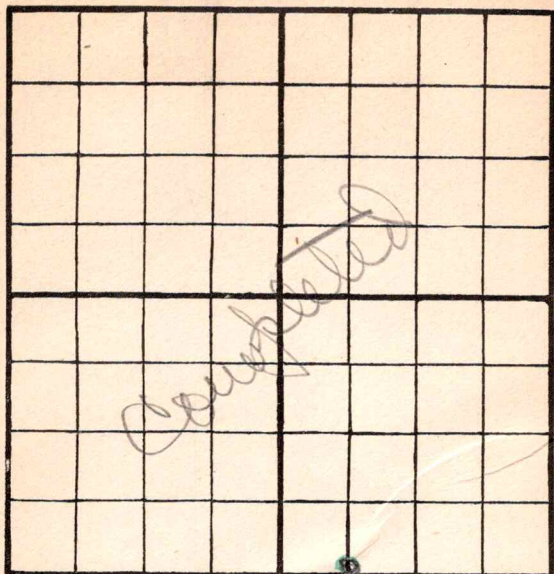

SOUTH

Location _____

Rig Up _____

Drilling Remarks:

Drilling Remarks:

RECORD

PRODUCTION

Cased _____ in. _____ ft.

1st 24 hrs. Nat. _____

Sand _____

1st 24 hrs. after shot _____

Gas _____

Gas _____ cu. ft.

Oil _____

Dry Hole _____

Total Depth _____

Abandoned _____

Map No. 119 Sec. 3 Twp. 26 R. 4

Well No. 10 Shriver

Empire Company

Contractor

NORTH

WEST

EAST

SOUTH

Location -----

Rig up.

Drilling and Remarks:

RECORD

Cased _____ in., _____ ft.

Sand_____

Gas -----

Oil _____

Total Depth_____

PRODUCTION

1st 24 hrs. Nat. -----

1st 24 hrs. after shot_____

Gas.....Cu. Ft.

Dry Hole_____

Abandoned_____

Date _____

6/3 191 S. C. C. Scout

Map No. _____ Sec. 3 Twp. 26 R. 4

Well No. 10 Shriener
Camp Company

Contractor

NORTH

WEST

EAST

SOUTH

Location _____

Rig up_____

Drilling and Remarks:

RECORD

Cased-----in., -----ft.

Sand_____

Gas -----

Oil_____

Total Depth_____

PRODUCTION

1st 24 hrs. Nat. -----

1st 24 hrs. after shot-----

Gas_____Cu. Ft.

Dry Hole.....

Abandoned.....

Date _____

Date 7/3 1911 J. Conley Scout

Map No. _____ Sec. 3 Twp. 26 R. 4Well No. 10 Shriner

_____ Company

_____ Contractor

NORTH

WEST

EAST

SOUTH

Location _____

Rig up ☒

Drilling and Remarks:

RECORD

Cased _____ in., _____ ft.

Sand _____

Gas _____

Oil _____

Total Depth _____

PRODUCTION

1st 24 hrs. Nat. _____

1st 24 hrs. after shot _____

Gas _____ Cu. Ft.

Dry Hole _____


Abandoned _____

Date

7/10 1918 Scout

Map No. _____ Sec. 3 Twp. 26 R. 4Well No. 10 Shrin

_____ Company

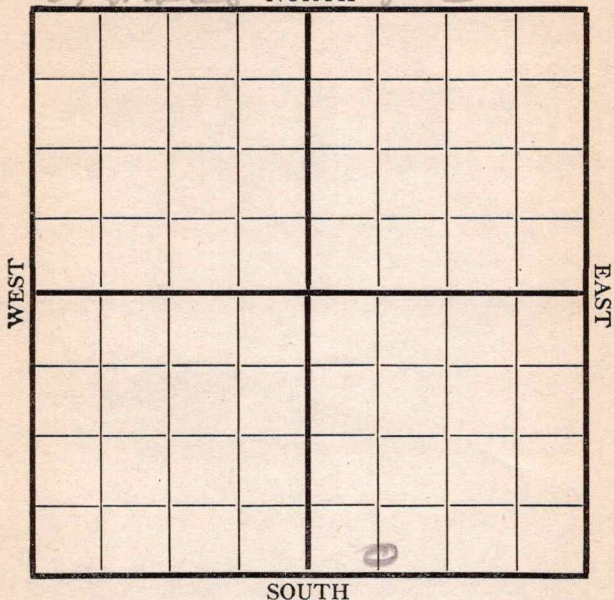Muth & Lacey Co ContractorEldorado NORTH TC

SOUTH

Location _____

Rig up _____

Drilling and Remarks:

RECORD

Cased _____ in., _____ ft.

Sand _____

Gas _____

Oil _____

Total Depth _____

PRODUCTION

1st 24 hrs. Nat. _____

1st 24 hrs. after shot _____

Gas _____ Cu. Ft.

Dry Hole _____

Abandoned _____

Date

7/17 191 P. C. C. C. Scout


Map No. _____ Sec. 3 Twp. 26 R. 4
 Well No. 10 Shriener
 _____ Company
 _____ Contractor

NORTH							
WEST							
SOUTH							
EAST							

Location _____ Rig up _____ Drilling and Remarks: 250	RECORD
	Cased _____ in., _____ ft. Sand _____ Gas _____ Oil _____ Total Depth _____
	PRODUCTION
	1st 24 hrs. Nat. _____ 1st 24 hrs. after shot _____ Gas _____ Cu. Ft. Dry Hole _____ Abandoned _____

Date 7/24 1918 J. C. Cady Scout

Map No. _____ Sec. 3 Twp. 26 R. 4
 Well No. 10 Shriver
Empire Company
 Contractor

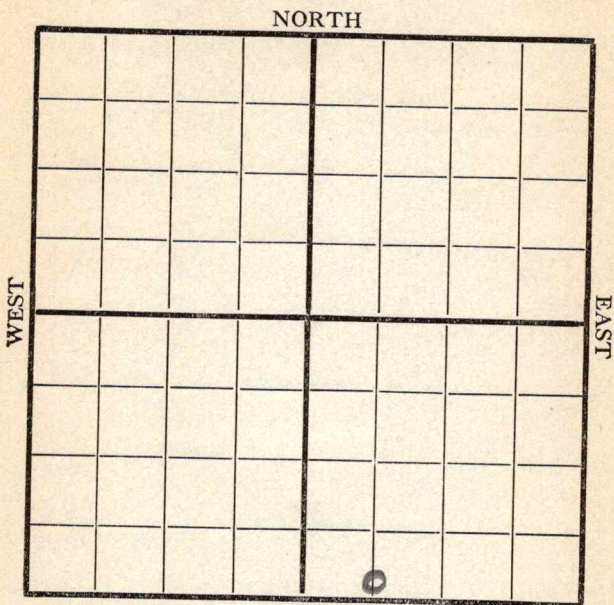

SOUTH

RECORD

Location _____

Rig up _____

Drilling and Remarks:

640

Cased _____ in., _____ ft.

Sand _____

Gas _____

Oil _____

Total Depth _____

PRODUCTION

1st 24 hrs. Nat. _____

1st 24 hrs. after shot _____

Gas _____ Cu. Ft.

Dry Hole _____

Abandoned _____

Date

7/31

191


S. C. Conroy

Scout

Map No. _____ Sec. 3 Twp. 26 R. 4Well No. 10 Shriver

Company _____

Contractor _____

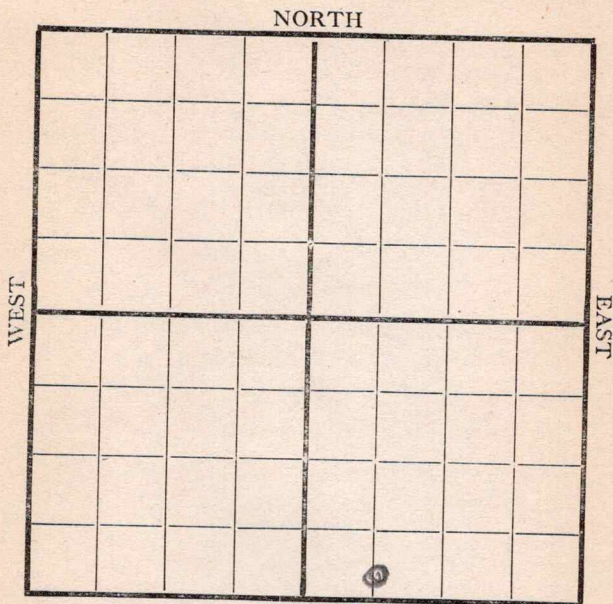Location 200 S
660 W

Rig up _____

Drilling and Remarks:

890

RECORD

Cased _____ in., _____ ft.

Sand _____

Gas _____

Oil _____

Total Depth _____

PRODUCTION

1st 24 hrs. Nat. _____

1st 24 hrs. after shot _____

Gas _____ Cu. Ft.

Dry Hole _____

Abandoned _____

Date

8/7

191

J. C. Cuddy

Scout

Map No. _____ Sec. 3 Twp. 26 R. 4

Well No. 10 Shaven


E. M. M. Co. Company

Contractor

NORTH

WEST

EAST

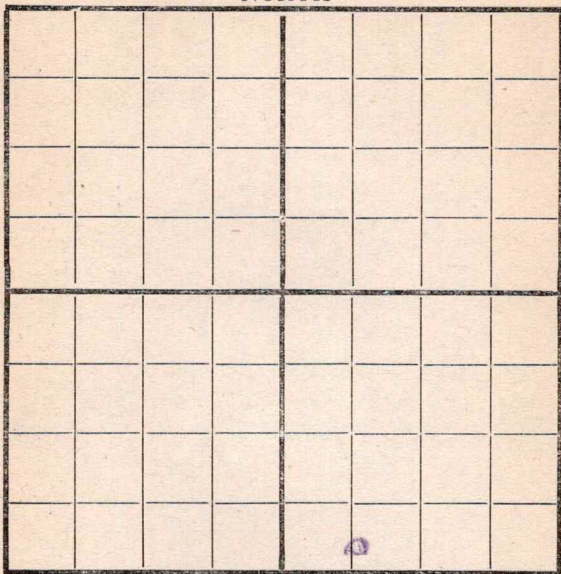

SOUTH

Location 200 S 660 W

Rig up _____

Drilling and Remarks:

1538'

RECORD

Cased _____ in., _____ ft.

Sand _____

Gas _____

Oil _____

Total Depth _____

PRODUCTION

1st 24 hrs. Nat. _____

1st 24 hrs. after shot _____

Gas _____ Cu. Ft.

Dry Hole _____

Abandoned _____

Date

8/15 1918

Oyle Scout

Map No. _____ Sec. 3 Twp. 26 R. 4Well No. 10 Shriver


Company _____

Contractor _____

NORTH

WEST

EAST

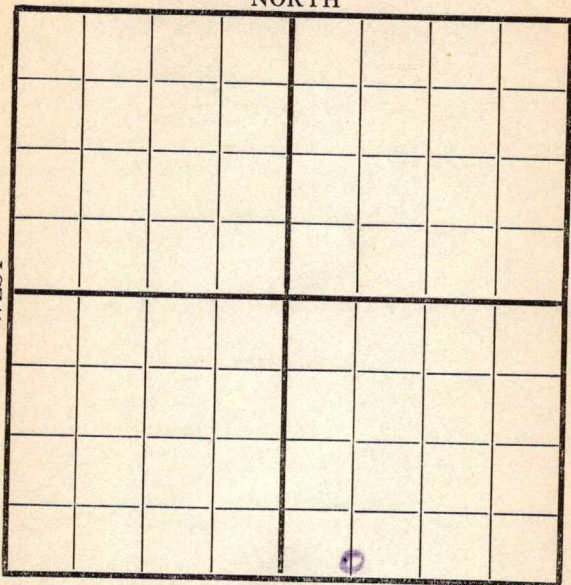

SOUTH

200' A - 660 W.

RECORD

Location _____

Cased _____ in., _____ ft.

Rig up _____

Sand _____

Drilling and Remarks:

Gas _____

Oil _____

Total Depth _____

1750'

PRODUCTION

1st 24 hrs. Nat. _____

1st 24 hrs. after shot _____

Gas _____ Cu. Ft.

Dry Hole _____

Abandoned _____

Date


8/221918

Pyle

Scout

Map No. K14 Sec. 3 Twp. 26 R. 4Well No. 10 ShriverEngine Company

Contractor

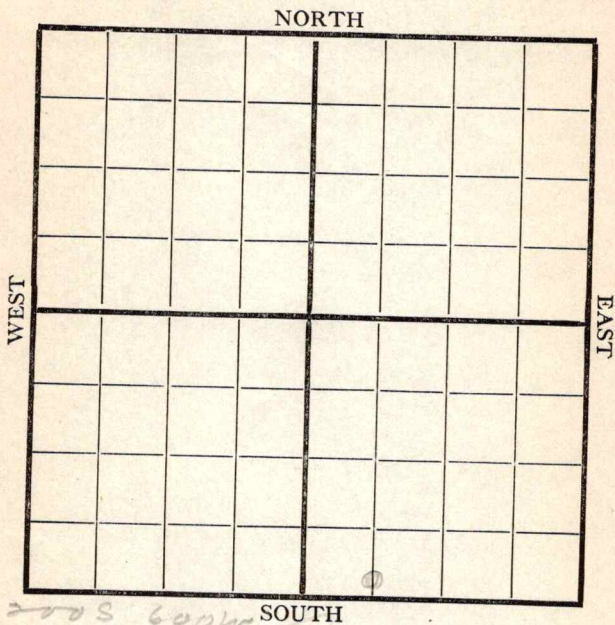

Location _____

Rig up _____

Drilling and Remarks:

2115

RECORD

Cased _____ in., _____ ft.

Sand _____

Gas _____

Oil _____

Total Depth _____

PRODUCTION

1st 24 hrs. Nat. _____

1st 24 hrs. after shot _____

Gas _____ Cu. Ft.

Dry Hole _____

Abandoned _____

Date

8/28 191


Scout

Map No. K14 Sec. 3 Twp. 26 R. 4

Well No. 10 Shriver

Engine Company

Contractor

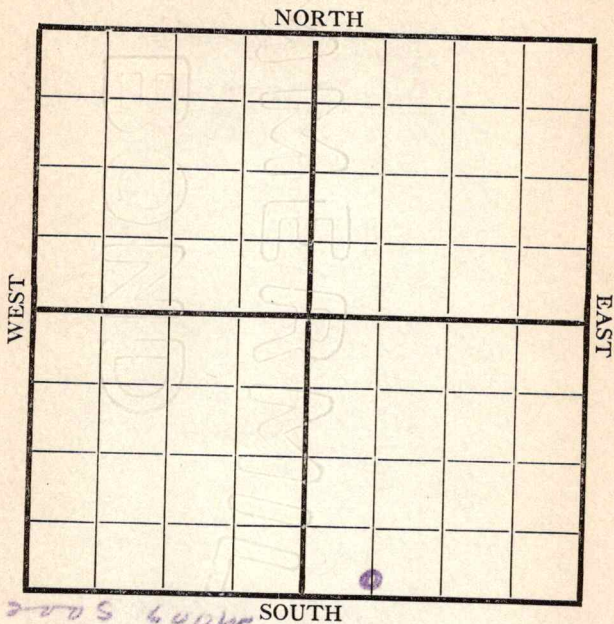

Location _____

Rig up _____

Drilling and Remarks:

2330

RECORD

Cased _____ in., _____ ft.

Sand _____

Gas _____

Oil _____

Total Depth _____

PRODUCTION

1st 24 hrs. Nat. _____

1st 24 hrs. after shot _____

Gas _____ Cu. Ft.

Dry Hole _____

Abandoned _____


Date

9/4

191

8 Condy

Scout

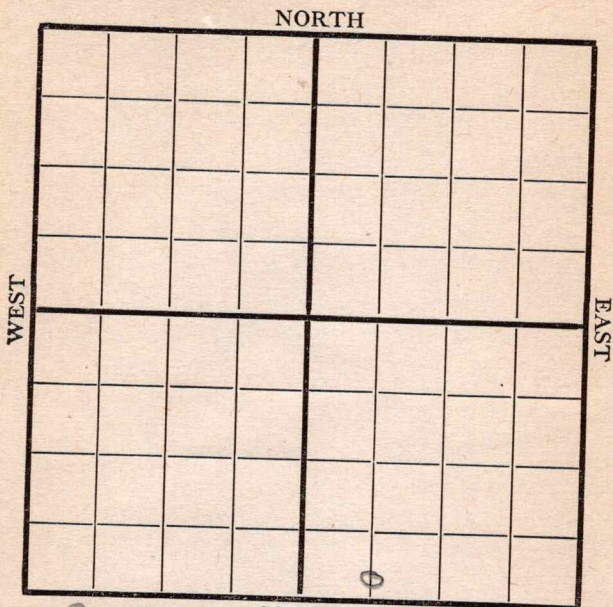Map No. 1514 Sec. 3 Twp. 26 R. 4Well No. 10 Shriver
Cummins Company
Contractor200 S - 660 W - SOUTH

Location _____

Rig up _____

Drilling and Remarks:

Top sand
2394

RECORD

Cased _____ in., _____ ft.

Sand _____

Gas _____

Oil _____

Total Depth _____

PRODUCTION

1st 24 hrs. Nat. _____

1st 24 hrs. after shot _____

Gas _____ Cu. Ft.

Dry Hole _____

Abandoned _____

Date

9/11191Cummins

Scout

Map No. 1514 Sec. 3 Twp. 26 R. 4Well No. 10 Shriver FarmEngine Company

NORTH

WEST

COMPLETED

EAST

SOUTH

Location _____

Rig up _____

Drilling and remarks:

Est. ✓50 Bbls

RECORD

Cased _____ in. _____ Ft.

Sand 2394-2447

Gas _____

Oil _____

Total Depth _____

PRODUCTION

1st 24 hrs. Nat. _____

1st 24 hrs. after shot _____

Gas _____ Cu. Ft.

Dry Hole _____

Abandoned _____

Date

9/18, 1918, S. Cardy Scout