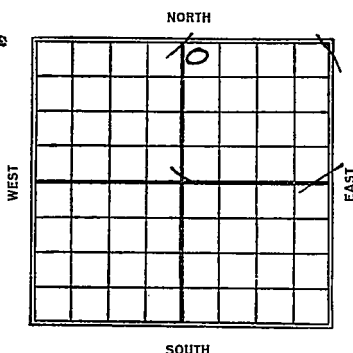


Map No. _____ Sec. 29 Twp. 23 R. 13Well No. 6 Dehlingen Farm
Cosden Oil & Gas Company200 Ft. from N. Line ^s

_____ Ft. from S. Line

_____ Ft. from E. Line

200 Ft. from W. LineDate
1923

REPORT

3/5 Location (N).
6/23 Topline 1674 - Sand
 1687-98 - Shot 40 qts.
 Est. 90 Bbls.

Map No. ~~KANSAS~~ 17 Sec. 29 Twp. 23 R. 13Well No. 6 DehlingerCosden Company

Contractor

FIRST REPORT

SECTION PLAT

200 Ft. from N. Line

Ft. from S. Line

Ft. from E. Line

200 Ft. from W. Line

		<u>0</u>	

Location V V

Rig up

Drilling and Remarks:

RECORD

Cased _____ in., _____ ft.

Sand _____

Gas _____

Oil _____

Total Depth _____

PRODUCTION

1st 24 hrs. Nat. _____

1st 24 hrs. after shot _____

Gas _____ Cu. Ft.

Dry Hole _____

Abandoned _____

Date

MAR 22 1923

M. A. BENEAR

192

Scout

Map No. **44N 29** Sec. **29** Twp. **23** R. **13**Well No. **6 Lachman**
Gas New O & B Company

Contractor

COMPLETED SECTION PLAT**260** Ft. from N. Line

_____ Ft. from S. Line

_____ Ft. from E. Line

200 Ft. from W. Line

		0	

Location _____

Rig up _____

Drilling and Remarks:

Tap Line 1674
and { 1687
1697

40 feet 90 ft**RECORD**

Cased _____ in., _____ ft.

Sand _____

Gas _____

Oil _____

Total Depth _____

PRODUCTION

1st 24 hrs. Nat. _____

1st 24 hrs. after shot _____

Gas _____ Cu. Ft.

Dry Hole _____

Abandoned _____

Date

JUN 23 1923**A. BENEAR**

192

Scout