

LOCATION NOTICE


TULSA, OKLA. March 5, 1923

To Mr. Lloyd Snyder,

ADDRESS Box 645, Arkansas City, Kansas.

Gosden Oil & Gas Company WILL DRILL A WELL AS
DESCRIBED BELOW, AND THIS NOTICE WILL BE YOUR AUTHORITY FOR COMMENCEMENT OF WORK.

THE LOCATION WILL BE ON C. F. Dellinger "B" FARM
IN NB $\frac{1}{4}$ OF SECTION 29 TOWNSHIP 23S RANGE 13E
Greenwood COUNTY, STATE OF Kansas.

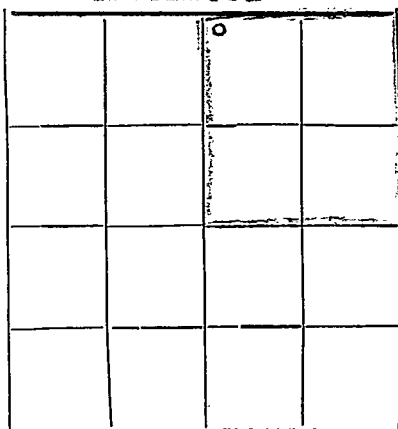

WELL No. 6

200 FEET FROM NORTH LINE

FEET FROM EAST LINE

FEET FROM SOUTH LINE

200 FEET FROM WEST LINE

REMARKS: _____

(SIGNED) *Gosden*

COPIES To

ACCOUNTING DEPT.
ENGINEERING DEPT.
LEGAL DEPT.
RENTAL DEPT.
SCOUTING DEPT. ✓