


Map No. _____ Sec. 3 Twp. 26 R. 4

Well No. 12 Shriver Farm
Empire Company

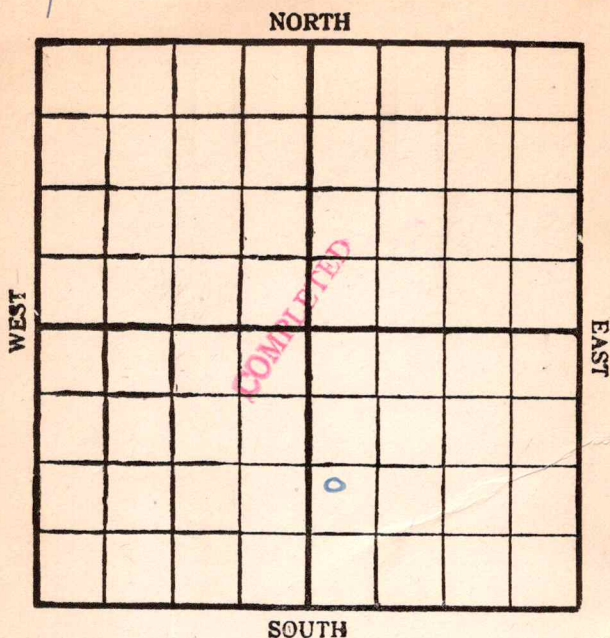

Location _____

Drilling Remarks:

Rig Up _____

Drilling Remarks:

RECORD

Cased _____ in. _____ ft.

Sand _____

Gas _____

Oil _____

Total Depth _____

PRODUCTION

1st 24 hrs. Nat. _____

1st 24 hrs. after shot _____

Gas _____ cu. ft.

Dry Hole _____

Abandoned _____


Map No. 1514 Sec. 3 Twp. 26 R. 4Well No. 12 ShriverEngine Company

Contractor

NORTH

WEST

EAST

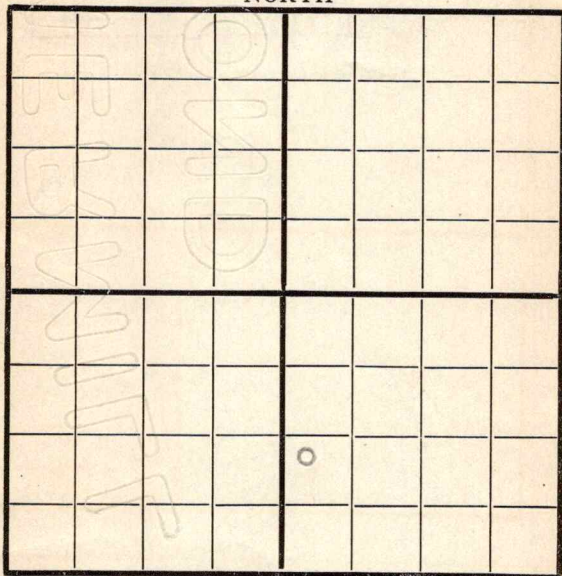

SOUTH

1120 S 200 W

Location _____

Rig up _____

Drilling and Remarks:

RECORD

Cased _____ in., _____ ft.

Sand _____

Gas _____

Oil _____

Total Depth _____

PRODUCTION

1st 24 hrs. Nat. _____

1st 24 hrs. after shot _____

Gas _____ Cu. Ft.

Dry Hole _____

Abandoned _____

FIRST REPORT

Date

11/201918S. Cordiff

Scout


Map No. K14 Sec. 3 Twp. 26 R. 4Well No. 12 Shriver
Empire Company

Contractor

NORTH

WEST

EAST

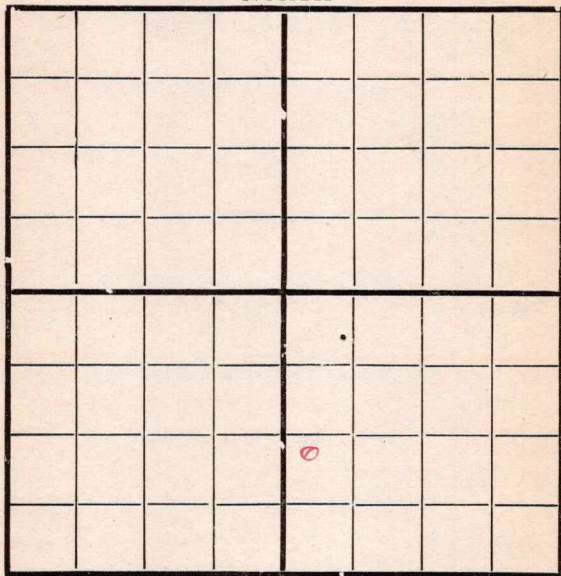

SOUTH

1120 S-200 W

Location _____

Rig up ✓

Drilling and Remarks:

RECORD

Cased _____ in., _____ ft.

Sand _____

Gas _____

Oil _____

Total Depth _____

PRODUCTION

1st 24 hrs. Nat. _____

1st 24 hrs. after shot _____

Gas _____ Cu. Ft.

Dry Hole _____

Abandoned _____

Date

11/27

191

J. Condy Scout

Map No. K14 Sec. 3 Twp. 26 R. 4Well No. 12 ShriverEngine Company

Contractor

NORTH

WEST

EAST

SOUTH

Location _____

Rig up ☒

Drilling and Remarks:

RECORD

Cased _____ in., _____ ft.

Sand _____

Gas _____

Oil _____

Total Depth _____

PRODUCTION

1st 24 hrs. Nat. _____

1st 24 hrs. after shot _____

Gas _____ Cu. Ft.

Dry Hole _____

Abandoned _____

Date

191 8Candey Scout


Map No. K14 Sec. 3 Twp. 26 R. 4Well No. 12 ShriverCompany Engine

Contractor _____

NORTH

WEST

EAST

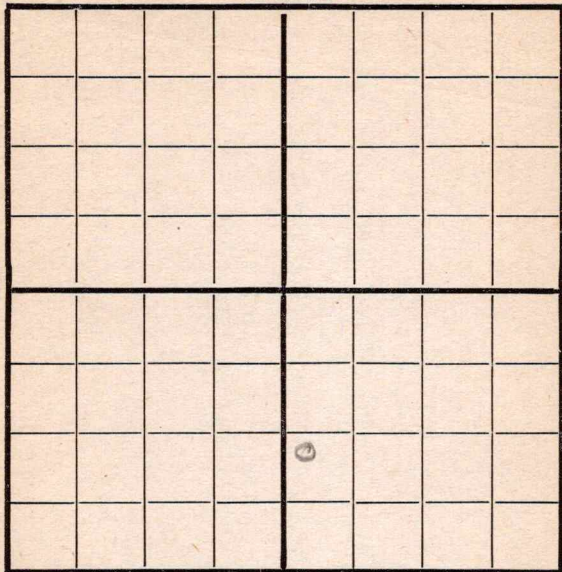

SOUTH

Location _____

Rig up ☒

Drilling and Remarks:

RECORD

Cased _____ in., _____ ft.

Sand _____

Gas _____

Oil _____

Total Depth _____

PRODUCTION

1st 24 hrs. Nat. _____

1st 24 hrs. after shot _____

Gas _____ Cu. Ft.

Dry Hole _____

Abandoned _____

Date

12/11 191 S. Conroy Scout

Map No. K14 Sec. 3 Twp. 26 R. 4
 Well No. 12 Shriver
Empire Company
 Contractor

NORTH								
WEST								EAST
SOUTH								

1120 S. 200 W

Location _____

Rig up ☒ _____

Drilling and Remarks:

RECORD

Cased _____ in., _____ ft.

Sand _____

Gas _____

Oil _____

Total Depth _____

PRODUCTION

1st 24 hrs. Nat. _____

1st 24 hrs. after shot _____

Gas _____ Cu. Ft.

Dry Hole _____

Abandoned _____

Date

12/18 1918 Candy Scout


Map No. K14 Sec. 3 Twp. 26 R. 4Well No. 12 ShriverCompany Engine

Contractor _____

NORTH

WEST

EAST

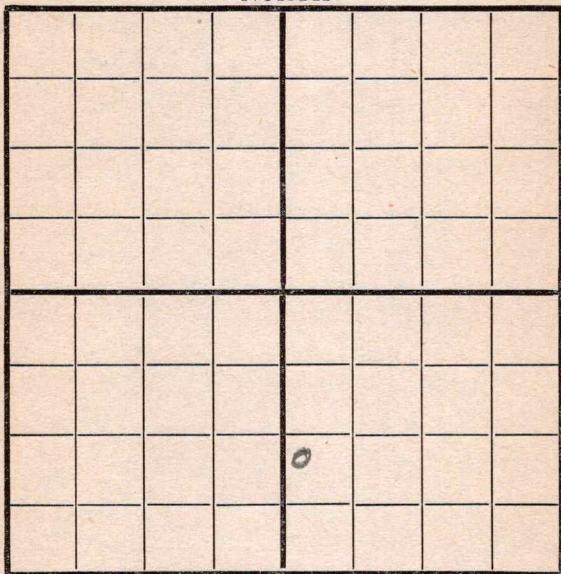

SOUTH

Location _____

Rig up. ☒

Drilling and Remarks:

RECORD

Cased _____ in., _____ ft.

Sand _____

Gas _____

Oil _____

Total Depth _____

PRODUCTION

1st 24 hrs. Nat. _____

1st 24 hrs. after shot _____

Gas _____ Cu. Ft.

Dry Hole _____

Abandoned _____

Date

12/25-8 Conley Scout

Map No. K14 Sec. 3 Twp. 26 R. 4

Well No. 12 Shiner


Engine Company

Contractor

NORTH

WEST

EAST

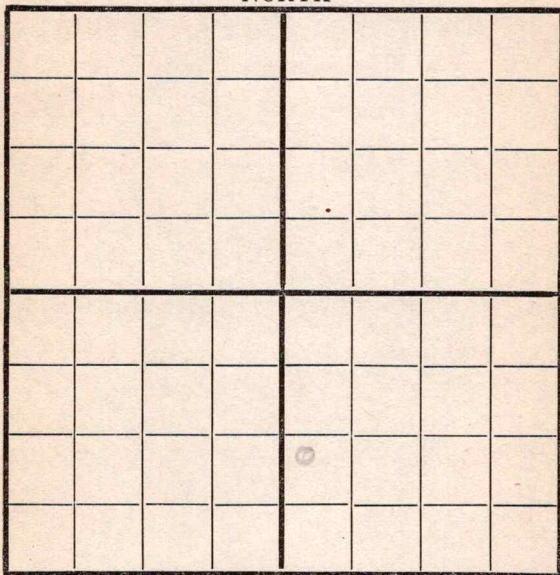

SOUTH

11203-200 W

Location _____

Rig up ☒ _____

Drilling and Remarks:

RECORD

Cased _____ in., _____ ft.

Sand _____

Gas _____

Oil _____

Total Depth _____

PRODUCTION

1st 24 hrs. Nat. _____

1st 24 hrs. after shot _____

Gas _____ Cu. Ft.

Dry Hole _____

Abandoned _____

Date

1/1 191 9 Conroy Scout

Map No. K14 Sec. 3 Twp. 26 R. 4

Well No. 12 Shriver


Engine Company

Contractor

NORTH

WEST

EAST

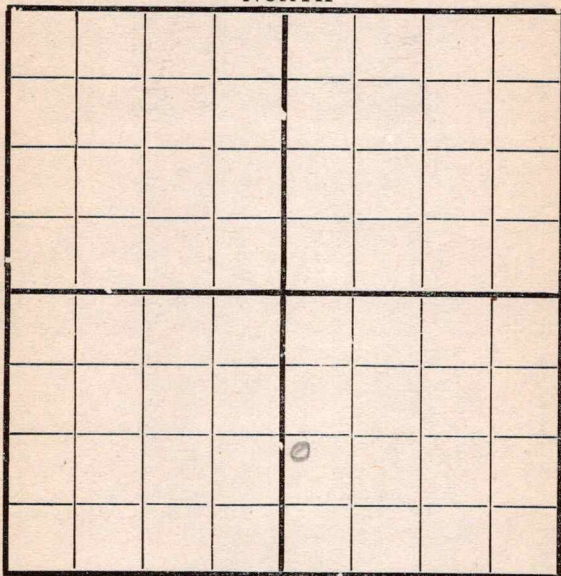

SOUTH

1120 S 200 W

Location _____

Rig up _____

Drilling and Remarks:

Spudding

RECORD

Cased _____ in., _____ ft.

Sand _____

Gas _____

Oil _____

Total Depth _____

PRODUCTION

1st 24 hrs. Nat. _____

1st 24 hrs. after shot _____

Gas _____ Cu. Ft.

Dry Hole _____

Abandoned _____

Date

1/8 1919 Cowley Scout

Map No. K14 Sec. 3 Twp. 26 R. 4
Well No. 12 Shriver
Engine Company _____ Contractor _____

NORTH							
WEST							
							EAST
SOUTH							

Location _____ Rig up _____ Drilling and Remarks: <u>120</u>	RECORD Cased _____ in., _____ ft. Sand _____ Gas _____ Oil _____ Total Depth _____
	PRODUCTION 1st 24 hrs. Nat. _____ 1st 24 hrs. after shot _____ Gas _____ Cu. Ft. Dry Hole _____ Abandoned _____

Date 1/15 1919 Conley Scout


Map No. 1514 Sec. 3 Twp. 26 R. 4Well No. 12 ShriverEmgrine Company

Contractor

NORTH

WEST

EAST

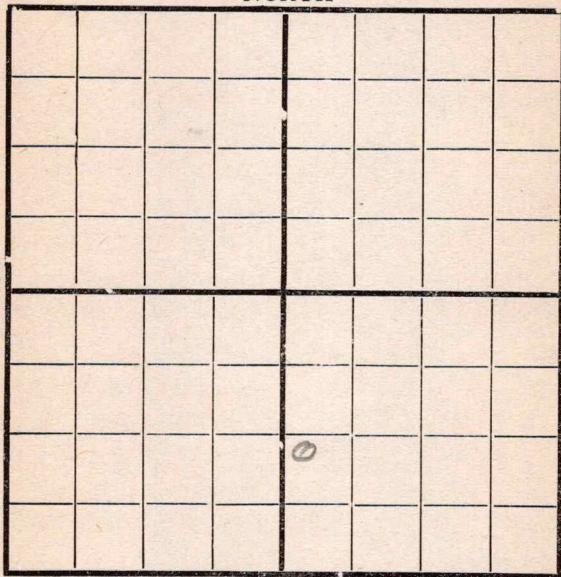

SOUTH

1120 S - 2nd W

Location _____

Rig up _____

Drilling and Remarks:

230

RECORD

Cased _____ in., _____ ft.

Sand _____

Gas _____

Oil _____

Total Depth _____

PRODUCTION

1st 24 hrs. Nat. _____

1st 24 hrs. after shot _____

Gas _____ Cu. Ft.


Dry Hole _____

Abandoned _____

Date

1/33 191 7 Candys Scout

Map No. K14 Sec. 3 Twp. 26 R. 4
 Well No. 12 Shriver
Empire Company
 Contractor

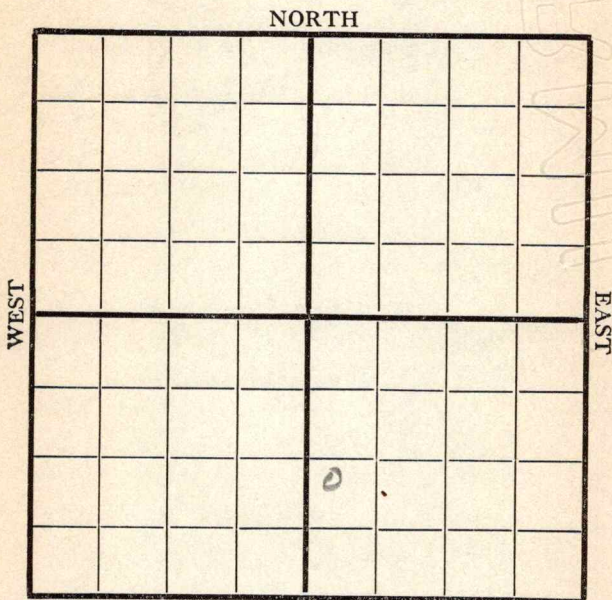

200 W 1120 S

RECORD

Location _____

Cased _____ in., _____ ft.

Rig up _____

Sand _____

Drilling and Remarks:

Gas _____

Oil _____

Total Depth _____

PRODUCTION

1st 24 hrs. Nat. _____

1st 24 hrs. after shot _____

Gas _____ Cu. Ft.

Dry Hole _____

Abandoned _____

Date

3/8 1919

Pyle

Scout

Map No. K14 Sec. 3 Twp. 26 R. 4Well No. 12 ShriverEmpire Company

Contractor

NORTH

WEST

EAST

SOUTH

COMPLETED

Location _____

Rig up _____

Drilling and Remarks:

55 bbls12 hours

RECORD

Cased _____ in., _____ ft.

Sand 2402 - 2422

Gas _____

Oil _____

Total Depth _____

PRODUCTION

1st 24 hrs. Nat. _____

1st 24 hrs. after shot _____

Gas _____ Cu. Ft.

Dry Hole _____

Abandoned _____

Date

5/6 1919G. J. L. Scout