


Map No. Kansas Sec. 1 Twp. 23 R. 9 ✓

Well No. 1 Hartley Farm
White Eagle Company

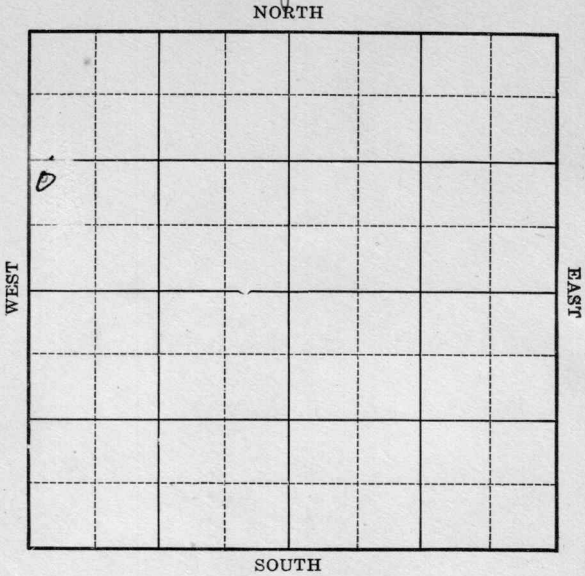

Location _____
Drilling Remarks _____

Rig Up _____
Drilling Remarks _____

RECORD

Cased _____ in. _____ ft.
Sand _____
Gas _____
Oil _____
Total Depth _____

PRODUCTION

1st 24 hrs. Nat. _____
1st 24 hrs. after shot _____
Gas _____ cu. ft.
Dry Hole _____
Abandoned _____

Map No. Kansas Sec. 1 Twp. 23 R. 9
 Well No. 1 Hartley Farm
White Eagle O. & R. Company

NORTH

WEST

EAST

SOUTH

Ft. from N. Line

990 Ft. from S. Line

Ft. from E. Line

330 Ft. from W. Line

Date

REPORT

1926

3/11

Location

3/18

Timbers

3/25

~~Rigging up~~ Spudding

4/1

4/7

Spudded and S.S.

4/14

4/21

4/30

5/8

Same.

5/12

5/19

6/2

6/10

same.

6/18

6/25

6-30

7/18

Dlg 1098

7/15

" 1500

7/22

" 2000'

7/28

Sand 2373-2453

260/10 bbls. T.O. 2453

K15 KANSAS

Map No. _____ Sec. 1 Twp. 23 R. 9

Well No. 1 Startley

White Eagle Oil & Gas Company

Contractor

SECTION PLAT

_____ Ft. from N. Line

990 Ft. from S. Line

_____ Ft. from E. Line

330 Ft. from W. Line

FIRST REPORTS

o			

Location _____

Rig up _____

Drilling and Remarks:

RECORD

Cased _____ in., _____ ft.

Sand _____

Gas _____

Oil _____

Total Depth _____

PRODUCTION

1st 24 hrs. Nat. _____

1st 24 hrs. after shot _____

Gas _____ Cu. Ft.

Dry Hole _____

Abandoned _____

Date

MAR 11 1926

CHAS. L. SHERWOOD

192

Scout

Well No. 11 11th May

White Eagle Over Company

Contractor

COMPLETED

SECTION PLAT

Ft. from N. Line

990 Ft. from S. Line

Ft. from E. Line

330 Ft. from W. Line

0			

Location -----

Rig up -----

Drilling and Remarks:

262 / 10 lbs.

RECORD

Cased-----in., ----- ft.

Sand 2373-2453

Gas _____

Oil-----

Total Depth 2453

PRODUCTION

1st 24 hrs. Nat. -----

1st 24 hrs. after shot-----

Gas-----Cu. Ft.

Dry Hole-----

Abandoned-----

Date _____

JUL 28 1926

192

CHAS. L. SHERWOOD

Scout