


Map No. Kansas Greenwood Sec. 1 Twp. 23 R. 9 ✓

Well No. 2 Hartley Farm _____
Prairie O. & G. Company

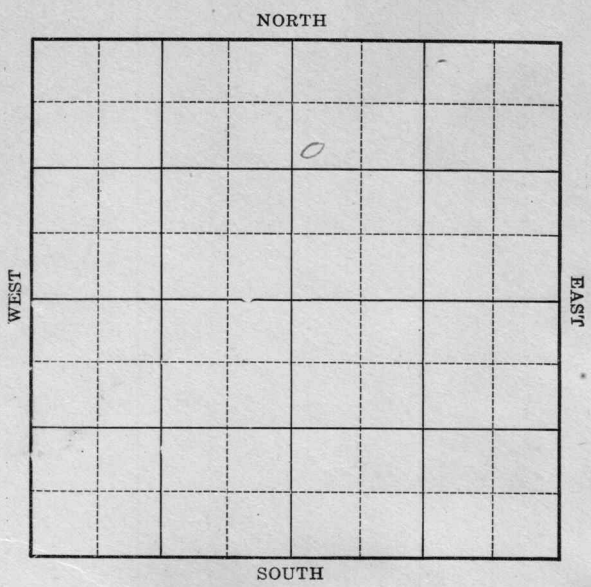

Location _____

Drilling Remarks _____

Rig Up _____

Drilling Remarks _____

RECORD

Cased _____ in. _____ ft.

Sand _____

Gas _____

Oil _____

Total Depth _____

PRODUCTION

1st 24 hrs. Nat. _____

1st 24 hrs. after shot _____

Gas _____ cu. ft.

Dry Hole _____


Abandoned _____

Map No. Kansas Sec. 1 Twp. 23 R 9
 Well No. 2 Hartley Farm
Prairie O + G Company

NORTH

WEST

EAST

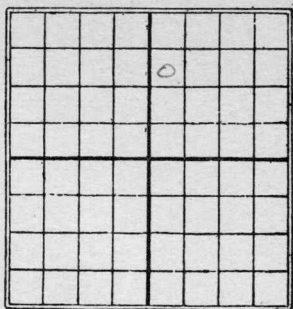

SOUTH

990 Ft. from N. Line

_____ Ft. from S. Line

_____ Ft. from E. Line

330 Ft. from W. Line

Date

REPORT

19263/25 Timber4/1 Rig4/7 _____4/14 Rign4/21 Spudz 1754/30 Dlg 9005/8 " 11505/12 " 1400'5/19 " 1700'6/2 " 23606/9 Stand 2425-2469 T.D. 2484
160 gts 20 bbls

Shenwood
 K15 KANSAS Sec. *1* Twp. *23* R. *9*
 Map No. *2* Well No. *Hantby*
Princo Oil Co. Company

Contractor

FIRST REPORTS

SECTION PLAT

990 Ft. from N. Line

Ft. from S. Line

Ft. from E. Line

330 Ft. from W. Line

		o	

Location *Timber*

Rig up

Drilling and Remarks:

RECORD

Cased _____ in., _____ ft.

Sand _____

Gas _____

Oil _____

Total Depth _____

PRODUCTION

1st 24 hrs. Nat. _____

1st 24 hrs. after shot _____

Gas _____ Cu. Ft.

Dry Hole _____

Abandoned _____

Date

MAR 25 1926

CHAS. L. SHERWOOD

192

Scout

Steenwood
 K15 KANSAS
 Map No. _____ Sec. *1* Twp. *23* R. *9*
 Well No. *2* *Hartley*
Maine Oil Co Company

Contractor

COMPLETED

SECTION PLAT

990 Ft. from N. Line

_____ Ft. from S. Line

_____ Ft. from E. Line

330 Ft. from W. Line

		0	

Location _____

Rig up _____

Drilling and Remarks:

oil 2464'

1607 20 BS.

RECORD

Cased _____ in., _____ ft.

Sand *2425-2469*

Gas _____

Oil _____

Total Depth *2484'*

PRODUCTION

1st 24 hrs. Nat. _____

1st 24 hrs. after shot _____

Gas _____ Cu. Ft.

Dry Hole _____

Abandoned _____

Date

JUN 9 1926

192

CHAS. L. SHERWOOD

Scout