


Greenwood

Map No. *KANS* Sec. *1* Twp. *23* R. *9*
 Well No. *1 B* *Hartly* Farm
Prairie Oil & Gas Company

NORTH

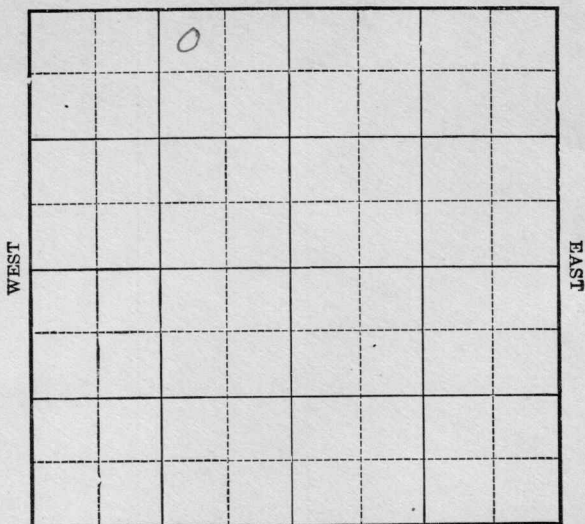

SOUTH

Location _____

Drilling Remarks

Rig Up _____

Drilling Remarks

RECORD

Cased _____ in. _____ ft.

Sand _____

Gas _____

Oil _____

Total Depth _____

PRODUCTION

1st 24 hrs. Nat. _____

1st 24 hrs. after shot _____

Gas _____ cu. ft.

Dry Hole _____

Abandoned _____


Greenwood

Map No. Kansas Sec. 1 Twp. 23 R. 9Well No. 1 B Hartly FarmPrairie O. & G. Company330 Ft. from N. Line

Ft. from S. Line

990 Ft. from E. Line

Ft. from W. Line

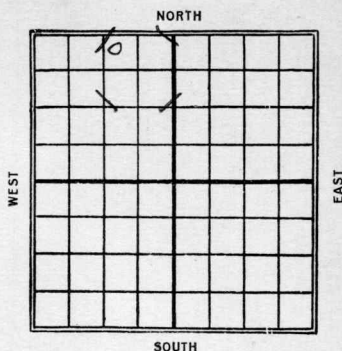

Date

REPORT

1920

6/30 Rig up

7/8 Same

7/15 Rigging up.

7/22 Spudding

7/28 Dlg 700

8/4 " 1650

8/11 Broken sd 2405-28

sdy shale 2428-43'

sand 2443-51, show

oil, sand 2514-25'

small show oil S.D.

8/18 Shot 120 gts, C.O.

8/25 Bkn sd 2405-28

120/ D & A. 2446-2524

D & A 2552

Greenwood
 K15 Map No. **KANSAS** Sec. *1 B* Twp. *23* R. *9*
1 B Well No. *1 B* *Hartley*
Prarie one Gas Co Company

Contractor

FIRST REPORTS

SECTION PLAT

330 Ft. from N. Line

_____ Ft. from S. Line

990 Ft. from E. Line

_____ Ft. from W. Line

Location _____

Rig up ☒

Drilling and Remarks:

RECORD

Cased _____ in., _____ ft.

Sand _____

Gas _____

Oil _____

Total Depth _____

PRODUCTION

1st 24 hrs. Nat. _____

1st 24 hrs. after shot _____

Gas _____ Cu. Ft.

Dry Hole _____

Abandoned _____

Date

JUN 30 1926

CHAS. L. SHERWOOD

192

Scout

15 KANSAS
 Map No. _____ Sec. 1 Twp. 23 R. 9
 Well No. 1 B Hootley
 Prairie oil & Gas Co. Company

Contractor _____

COMPLETED

SECTION PLAT


330 _____ Ft. from N. Line

_____ Ft. from S. Line

990 _____ Ft. from E. Line

_____ Ft. from W. Line

ABANDONED

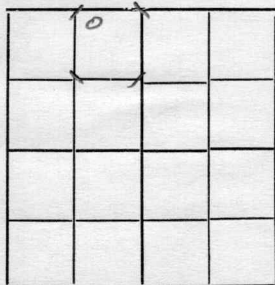

Location _____

Rig up _____

Drilling and Remarks:

Blow sb 2405-28
 Sdly shale 2428-43
 Sd 2443-51 Show
 Sd 2514-25
 120 2446-2524
 189 2552

RECORD

Cased _____ in., _____ ft.

Sand _____

Gas _____

Oil _____

Total Depth 2552'

PRODUCTION

1st 24 hrs. Nat. _____

1st 24 hrs. after shot _____

Gas _____ Cu. Ft.

Dry Hole ✓

Abandoned ✓

Date

AUG 25 1926

CHAS. L. SHERWOOD

192

Scout