


Map No. Kansas Sec. 2 Twp. 23 R. 9 ✓

Well No. 5 Green Farm

Transcontinental Company

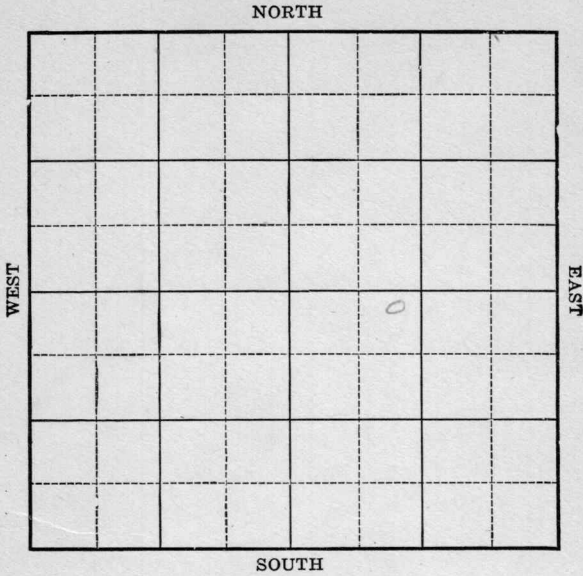

Location _____

Drilling Remarks

RECORD

Cased _____ in. • _____ ft.

Sand _____

Gas _____

Oil _____

Total Depth _____

Rig Up _____

Drilling Remarks

PRODUCTION

1st 24 hrs. Nat. _____

1st. 24 hrs. after shot _____

Gas _____ cu. ft.


Dry Hole _____

Abandoned _____

Map No. Kansas Sec. 2 Twp. 23 R 9Well No. 5 Green FarmTranscontinental Company330 Ft. from N. Line

Ft. from S. Line

Ft. from E. Line

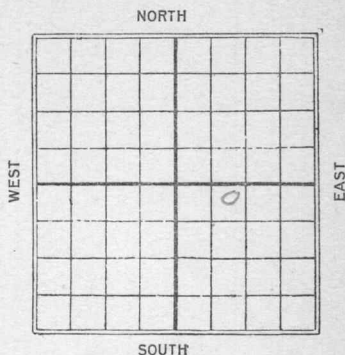990 Ft. from W. Line

Date

REPORT

19253/1 Rgn up5/1 2389-241180 gts 75 Bbls

Map No. 15 KANSAS Sec. 2 Twp. 23 R. 9Well No. 5 GreenTranscontinental Company

Contractor

FIRST REPORT

330 Ft. from N. Line

Ft. from S. Line

Ft. from E. Line

990 Ft. from W. Line

SECTION PLAT

Location

Rig up

Drilling and Remarks:

Rig up

RECORD

Cased _____ in., _____ ft.

Sand _____

Gas _____

Oil _____

Total Depth _____

PRODUCTION

1st 24 hrs. Nat. _____

1st 24 hrs. after shot _____

Gas _____ Cu. Ft.

Dry Hole _____

Abandoned _____

Date

3/1 1925

M. A. RENEAR Scout

Map No. 17 1/2 miles Sec. 2 Twp. 23 R. 9Well No. 5 BlowContinental Oil Co. Company

Contractor

COMPLETED

SECTION PLAT

330 Ft. from N. Line

Ft. from S. Line

Ft. from E. Line

990 Ft. from W. Line

		o	

Location

Rig up

Drilling and Remarks:

RECORD

Cased 2389-2411 in. ft.

Sand

Gas

Oil

Total Depth 2411

PRODUCTION

1st 24 hrs. Nat. _____

1st 24 hrs. after shot _____

Gas _____ Cu. Ft.

Dry Hole _____

Abandoned _____

Date

MAY 1 1925

192

CHAS. L. SHERWOOD
Scout

80/75 b/s