

Greenwood

Map No. *Kans* Sec. *2* Twp. *23* R. *9*

Well No. *1 Hartley* Farm

~~*Penalty et al*~~ Company

Greenland oil

NORTH

SOUTH

WEST

EAST

Location _____

Drilling Remarks

RECORD

Cased _____ in. _____ ft.

Sand _____

Gas _____

Oil _____

Total Depth _____

Rig Up _____

Drilling Remarks

PRODUCTION

1st 24 hrs. Nat. _____

1st. 24 hrs. after shot _____

Gas _____ cu. ft.

Dry Hole _____

Abandoned _____

Map No. Kans Sec. 2 Twp. 23 R. 9

Well No. 1 Hartley Farm


Renerly etal Company

990 Ft. from N. Line

_____ Ft. from S. Line

_____ Ft. from E. Line

330 Ft. from W. Line

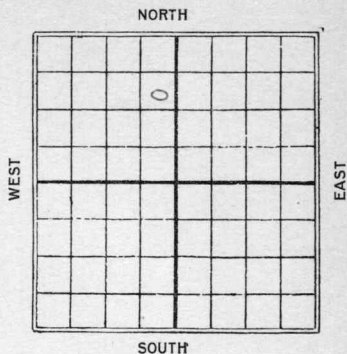

Date
1925

REPORT

2/8

R.O.G.

5/21

2333-2408 3 AM Gas

60 gts 75 Bbls

Map No. 13 **KANSAS** Sec. 2 Twp. 23 R. 9
 Well No. 1 Hartley (7809)
Remedy et al Company
 Contractor

FIRST REPORT**SECTION PLAT**990 Ft. from N. Line

Ft. from S. Line

Ft. from E. Line

330 Ft. from W. Line

	o		

Location

Rig up

Drilling and Remarks:

R.O. G.**RECORD**

Cased _____ in., _____ ft.

Sand _____

Gas _____

Oil _____

Total Depth _____

PRODUCTION

1st 24 hrs. Nat. _____

1st 24 hrs. after shot _____

Gas _____ Cu. Ft.

Dry Hole _____

Abandoned _____

Date

2/8 1925**M. A. BENEAR**

Scout

Map No. 15644 Sec. 2 Twp. 23 R. 9Well No. 1 "c" HarleyTobacco Land and Co. Company

Contractor

COMPLETED

SECTION PLAT

990 Ft. from N. Line

Ft. from S. Line

Ft. from E. Line

330 Ft. from W. Line

Location

Rig up

Drilling and Remarks:

607 75 bks

RECORD

Cased _____ in. _____ ft.

Sand 2333-2408

Gas _____

Oil _____

Total Depth 2408

PRODUCTION

1st 24 hrs. Nat. _____

1st 24 hrs. after shot _____

Gas 3 M Cu. Ft.

Dry Hole _____

Abandoned _____

Date

MAY 21 1925

192

CHAS. L. SHERWOOD

Scout