


Section 30 Township 23 Range 12DWell No. #1 MillardCompany H. A. Millard

NORTH

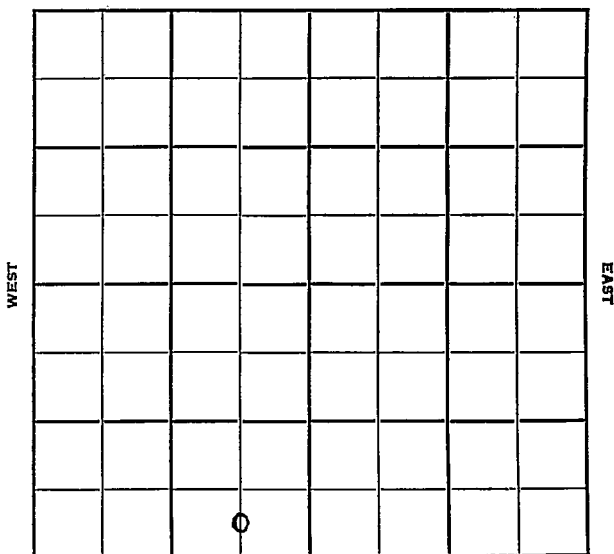

SOUTH

Greenwood KANSAS

Sec. 30 Twp. 23 R. 12 E ✓

Well No. # 1 Millard Farm

- H. A. Millard Company

Contractor

Semi-Wildcat


 Ft. from N. Line

330 Ft. from S. Line

660 Ft. from E. Line

 Ft. from W. Line

C S/2 SE SW

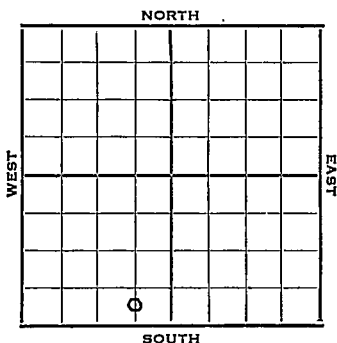

1951

Elev. -

R E P O R T

11/28

Spud 11-23-51

Miss 1849'

RTD 1851'

5" @ 1851'

12/19

Spud 11-23-51

Oil well TD 1863'

Miss 1849' 5" @ 1851' TD 1863'

500 A

Comp. 5 BOPD

COMPLETED

County **Greenwood** State **Kans as**

Sec. **30** (Blk. Twp.) **23** (Sur. Rge.) **12E** Map No.

Operator **H. A. Millard**

Well No. 1 Farm Willard

Elev.	Location	C S/2 SE SW
-------	----------	-------------

FIRST REPORT

330 Ft. From S Line SW

660 Ft. From E Line Quarter

1st. Report **NOV 28 1951**

Completion

Remarks


Spudding Date **11-23-51**

Drig. Data Semi Wildcat

Miss 1849 RTD 1851 5" @ 1851

J. E. TYRA

County Greenwood State Kansas
 Sec. 30 (Blk. 23) (Sur. 12E) (Twp. Map No.)
 Operator H. A. Millard
 Well No. 1 Farm Millard
 Elev. Location C S L SE SW

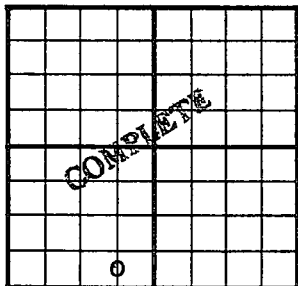

330 Ft. From S Line SW
660 Ft. From E Line Quarter
Ist. Report
Completion DEC 1 9 1951
Remarks Semi Wildcat

Spudding Date 11-23-51
Drlg. Data Oil well TD 1863
Miss. 1849 5" @ 1851 TD 1863 500 A
Comp. 5 bopd

J. E. TYRA