


Greenwood

Map No. *Kans.* Sec. *29* Twp. *23* R. *12*

Well No. *1 - Patterson* Farm

L. A. Parrish Company

Prairie NORTH *0 & Gas*

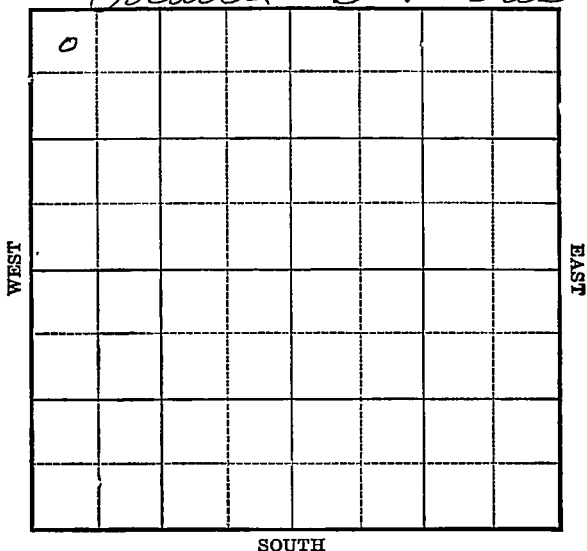

Location _____

Drilling Remarks _____

Rig Up _____

Drilling Remarks _____

RECORD

Cased _____ in. _____ ft.

Sand _____

Gas _____

Oil _____

Total Depth _____

PRODUCTION

1st 24 hrs. Nat. _____

1st 24 hrs. after shot _____

Gas _____ cu. ft.


Dry Hole _____

Abandoned _____

Map No. Kans Sec. 29 Twp. 23 R. 12Well No. 1 Patterson FarmL. H. Parrish Company
Prairie Oil & Gas NORTH COMPANY330 Ft. from N. Line

Ft. from S. Line

Ft. from E. Line

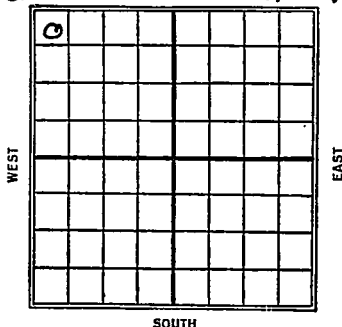330 Ft. from W. Line1926

Date

REPORT

9/22 Location
9/29 same
10/13 same
10/27 Rigging up machine
11/14 Drlg 1000
11/17 same
11/23 same
12/8 Dry sand 1685'-91'
 top line 1885'-Drlg 1933
12/15 Dry sand 1685'-91'
 Top line 1885' D&A. 1955

16 KANSAS 29 Twp. 23 R. 12
 Map No. Sec. Well No. 1 Luttonson
 L. K. Parrish Company

Contractor

FIRST REPORTS

SECTION PLAT

330 Ft. from N. Line

Ft. from S. Line

Ft. from E. Line

330 Ft. from W. Line

0			

Location ✓

Rig up

Drilling and Remarks:

RECORD

Cased _____ in., _____ ft.

Sand _____

Gas _____

Oil _____

Total Depth _____

PRODUCTION

1st 24 hrs. Nat. _____

1st 24 hrs. after shot _____

Gas _____ Cu. Ft.

Dry Hole _____

Abandoned _____

Date

SEP 22 1926


CHAS. I. SHERWOOD

Scout

Sherwood

16 KANSAS Sec. 29 Twp. 23 R. 12
 Map No. 1 Patterson Farm
 Well No. 1 Patterson Co. Company

NORTH

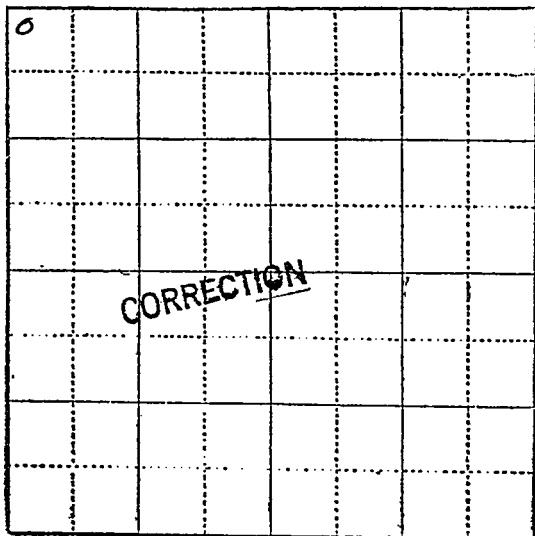

SOUTH

Location ✓

Rig up

Drilling and Remarks:

Chg Ownership

RECORD

Cased in., ft.
 Sand --
 Gas --
 Oil -- --
 Total Depth ..

PRODUCTION

1st 24 hrs. Nat.
 1st 24 hrs. after shot .
 Gas Cu. Ft.
 Dry Hole
 Abandoned ..

Date OCT 13 1928

CHAS. L. SHERWOOD

16 KANSAS

Map No. _____ Sec. 29 Twp. 23 R. 12

Well No. 1 Patterson

Maine Oil & Gas Co. Company

Contractor

COMPLETED

SECTION PLAT

330 Ft. from N. Line

_____ Ft. from S. Line

_____ Ft. from E. Line

330 Ft. from W. Line

ABANDONED

0			

Location _____

Rig up _____

Drilling and Remarks:

Dry Sand 1685-91'

top line 1885'

Dry

1955'

RECORD

Cased _____ in., _____ ft.

Sand _____

Gas _____

Oil _____

Total Depth 1955

PRODUCTION

1st 24 hrs. Nat. _____

1st 24 hrs. after shot _____

Gas _____ Cu. Ft.

Dry Hole ✓

Abandoned ✓

Date

DEC 15 1926

CHAS. L. SHERWOOD

192

Scout