
Form 51 5M 11-23 13898

Map No. Kansas Sec. 2 Twp. 23 R. 9

Well No. 4 Hartley Farm

Skelly Oil Co. Company

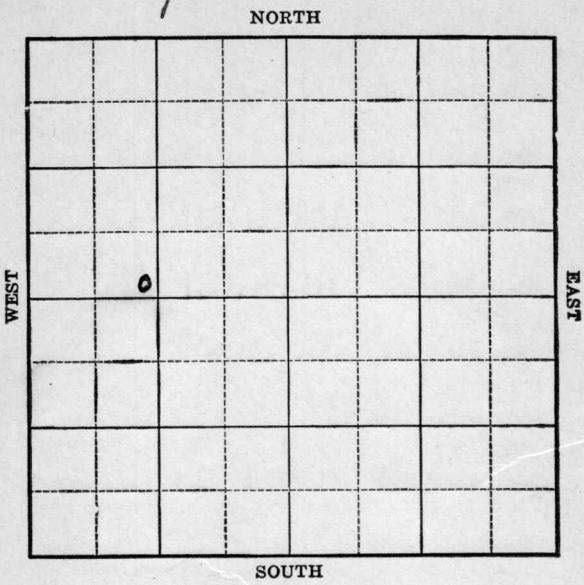

Location _____

Drilling Remarks:

Rig Up _____

Drilling Remarks:

RECORD

Cased _____ in. _____ ft.

Sand _____

Gas _____

Oil _____

Total Depth _____

PRODUCTION

1st 24 hrs. Nat. _____

1st 24 hrs. after shot _____

Gas _____ cu. ft.

Dry Hole _____


Abandoned _____

Form 252A 5M 8-24 16529

Map No. Kansas Sec. 2 Twp. 23 R 9

Well No. 4 Hartley Farm

Skelly Oil Company

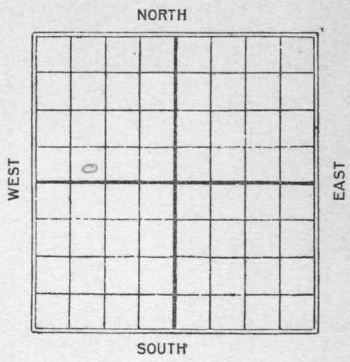

Ft. from N. Line

330 Ft. from S. Line

Ft. from E. Line

990 Ft. from W. Line

C.

Date 1925	REPORT
4/24	Location
5/29	———
6/5	Rig + Tools
6/12	Dry 560
6/19	" 1420
6/26	" 2000
7/3	S.D. 2112
7/10	T.D. 2614 - Bk. sd. 2408-21
	sks oil Top lime 2526-37
	Dry and Abd.

Form 26—1M Bks.—3-23—11959.

Map No. Brown Co. Sec. 2 Twp. 23 R. 9


Well No. 4 Hartley

Kelly Oil Co Company

Contractor

FIRST REPORTS

SECTION PLAT

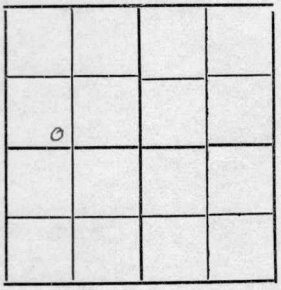

_____Ft. from N. Line

330 Ft. from S. Line

_____Ft. from E. Line

990 Ft. from W. Line

Location ✓

Rig up

Drilling and Remarks:

RECORD

Cased _____ in., _____ ft.

Sand

Gas

Oil

Total Depth

PRODUCTION

1st 24 hrs. Nat.

1st 24 hrs. after shot

Gas _____ Cu. Ft.

Dry Hole

Abandoned

Date

APR 24 1925

192

Mrs. L. Sherwood Scout

Form 26—1M Bks.—3-23—11959.

Map No. 15 1/16 ds Sec. 2 Twp. 23 R. 9

Well No. 4 Hartley

Kelly & Co Company

Contractor

COMPLETED

Ft. from N. Line


330 Ft. from S. Line

Ft. from E. Line

990 Ft. from W. Line

ABANDONED

SECTION PLAT

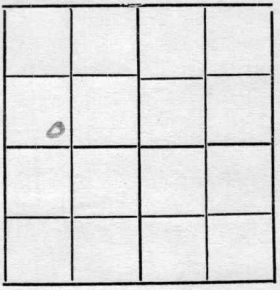

Location

Rig up

Drilling and Remarks:

Broken at 2408-
rk rk.
show oil top lime
2526-37'
dry & abd
TD 2614'

RECORD

Cased in., ft.

Sand

Gas

Oil

Total Depth 2614

PRODUCTION

1st 24 hrs. Nat.

1st 24 hrs. after shot

Gas Cu. Ft.

Dry Hole ✓

Abandoned ✓

Date

JUL 10 1925

192

CHAS. L. SHERWOOD

Scout