Butler


FORM 51 25M 8-50 WESTERN

KANSAS

Section 32 Township 23 Range 5E

Well No. #3 Eva Thompson

Company K. T. Weideman

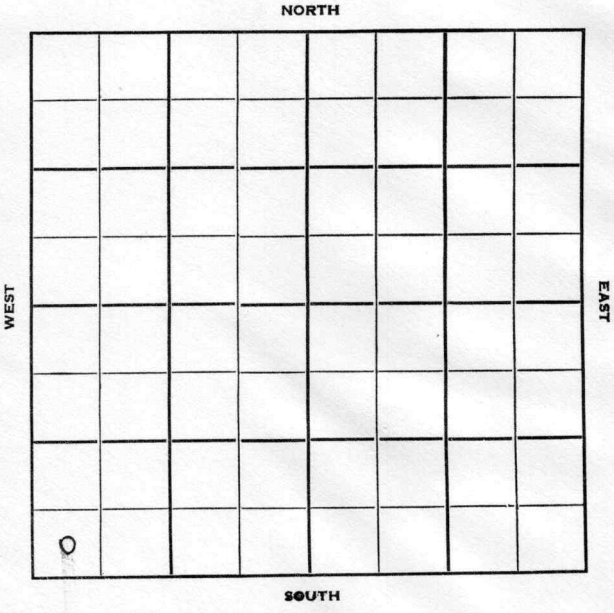

FORM 252-B
10M 8-51 TPCO.

Butler KANSAS

Sec. 32 Twp. 23 R. 5 E

Well No. # 3 Eva Thompson Farm

K. T. Weideman Company

K. T. Weideman Contractor


Ft. from N. Line

330 Ft. from S. Line

Ft. from E. Line

330 Ft. from W. Line

SW SW SW

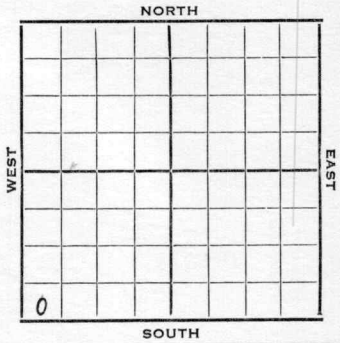

1951	Elev. 1488' REPORT
11/28	RUR
1952	
1/23	Oil well TD 2496 10" @ 102 KC 2083 B KC 2234 Cong. 2449 Miss. 2460 Marm. 2304-2424 TD 2462 7" @ 2462 DD 2496 Hydro. S/ 15 BOPD Comp. 35 BOPD

COMPLETED

FORM 275 FOR SALE BY KANSAS BLUE PRINT CO.


County Butler State Kansas

Sec. 32 (Blk. / Twp.) 23 (Sur. / Rge.) 5E Map No.

Operator K. T. Weideman

Well No. 3 Farm Eva Thompson

Elev. Location SW SW SW

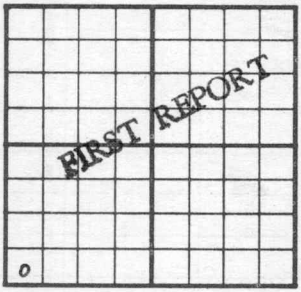

330 Ft. From S Line S W

330 Ft. From W Line Quarter

1st. Report NOV 2 8 1951

Completion

Remarks

K. T. Weideman - Contr.

Spudding Date

Drlg. Data

RUR

J. E. TYRA

FORM 275 FOR SALE BY KANSAS BLUE PRINT CO.


County Butler State Kansas

Sec. 32 (Blk. Twp.) 23 (Sur. Rge.) 5E Map No.

Operator K. T. Weidemann

Well No. 3 Farm Eva Thompson

Elev. 1488 Location SW SW SW

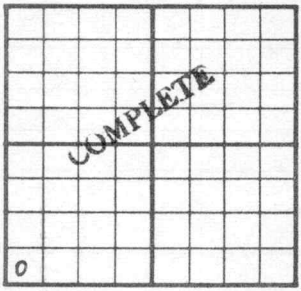

330 Ft. From S Line SW

330 Ft. From W Line Quarter

1st. Report

Completion JAN 2 3 1952

Remarks

Weidemann - Contr.

Spudding Date

Drlg. Data Oil well TD 2496

10" @ 102 KC 2083 B KC 2234

Cong. 2449 Miss. 2460 Marm. 2304-2424

~~TD~~ 2462 7" @ 2462 DD 2496 Hydro.

S/ 15 bopd Comp. 35 bopd

J. G. McGEHEE