
FORM 51 25M 8-50 WESTERN KANSAS Butler

Section 32 Township 23 Range 5-E

Well No. #1 Thompson

Company K T Weidemann

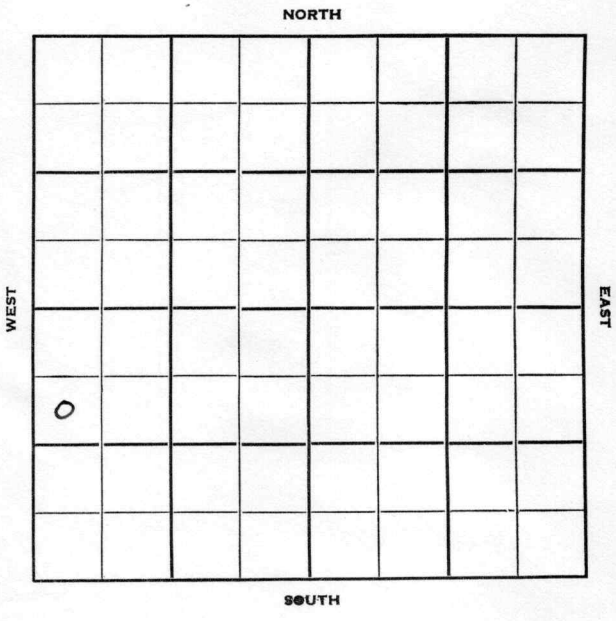

FORM 252-B
10M 10-50 PETROL

Butler KANSAS

Sec. 32 Twp. 23 R. 5E

Well No. #1 Thompson Farm

K. T. Weidemann Company

Contractor


990' Ft. from N. Line

Ft. from S. Line

Ft. from E. Line

330' Ft. from W. Line

SW NW SW

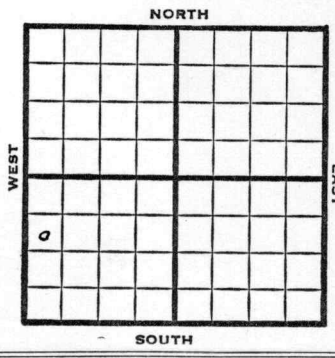

1950	Elev 1484' REPORT
11/15	RUR
12/6	Spud 11-13-50 8" @ 126 KC 2075 BKC 2234 Cong 2415 Ch Cong 2435 Miss lime 2441 5" @ 2444 TD 2465 FU 1300' oil Comp 35 bopd Completed

COMPLETED

FORM 275 FOR SALE BY KANSAS BLUE PRINT CO.


County Butler State Kansas

Sec. 32 (Blk. Twp.) 23 (Sur. Rge.) 5E Map No.

Operator K. T. Weidemann

Well No. 1 Farm Thompson

Elev. Location SW NW SW

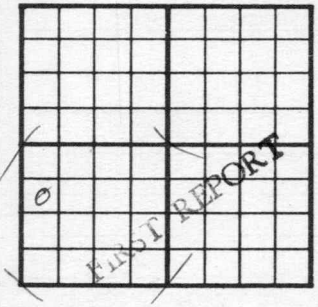

990 Ft. From N Line SW

330 Ft. From W Line Quarter

1st. Report NOV 15 1950

Completion

Remarks

Spudding Date

Drlg. Data

R U R

J. E. TYRA

FORM 275 FOR SALE BY KANSAS BLUE PRINT CO.


County Butler State Kansas

Sec. 32 (Blk. Twp.) 23 (Sur. Rge.) 5E Map No.

Operator K. T. Weidemann

Well No. 1 Farm Thompson

Elev. 1484 Location SW NW SW

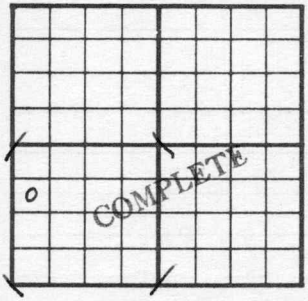

990 Ft. From N Line SW

330 Ft. From W Line Quarter

1st. Report

Completion DEC 6 1950

Remarks

Spudding Date 11-13-50

Drlg. Data Oil well TD 2465

8" @ 126 KC 2075 B KC 2235 Cong. 2415

Ch. Cong. 2435 Miss. lime 2441 T 2444

5" @ 2444 TD 2465 FU 1300' oil

Comp. 35 bopd

J. E. TYRA