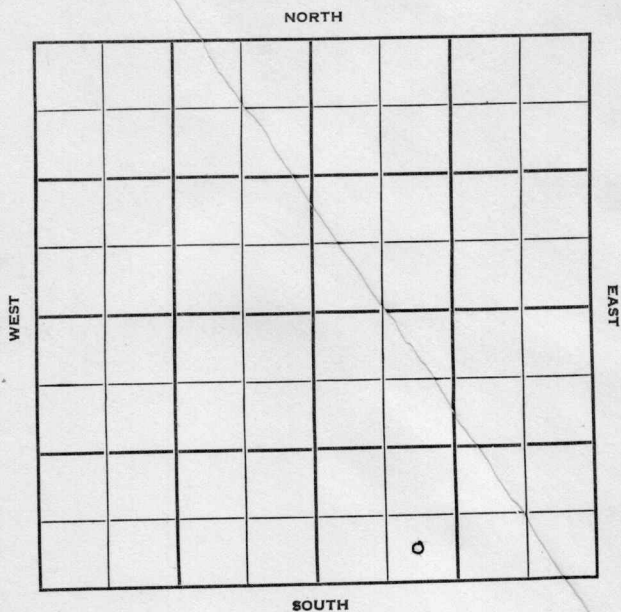


KANSAS

Section 33 Township 23 Range 5-EWell No. #1 HeymannCompany Rex & Morris

Butler ANSAS
23 5E ✓

Sec. 33 Twp. _____ R. _____

Well No. #1 Heymann Farm _____

Rex & Morris Company _____

Contractor _____

Ft. from N. Line

330'


Ft. from S. Line

Ft. from E. Line

990'

Ft. from W. Line

SE SW SE

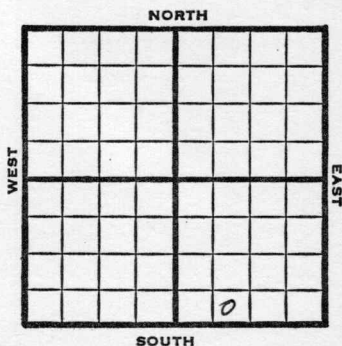

1950

Elev. 1441'

REPORT

5/24

Location

6/21

15½" @ 210'

13" @ 715'

Lans. 1815'

HFW 1815-20

8" @ 1855'

Miss 2420'

Kinderhook 2450'

Viola 2555'

HFW 2555-57 TD

D&A

TD 2557'

ABANDONED

Kansas

Map No. _____ Sec. 33 Twp. 23 R. 5EWell No. 1 HeymannRex & Morris Company

Contractor

SE SW SE

SECTION PLAT

FIRST REPORT			

_____ Ft. from N. Line

330 Ft. from S. Line

_____ Ft. from E. Line

990 Ft. from W. Line

Butler

Location X

Rig up _____

Drilling and Remarks:

RECORD

Cased _____ in., _____ ft.

Sand _____

Gas _____

Oil _____

Total Depth _____

PRODUCTION

1st 24 hrs. Nat. _____

1st 24 hrs. after shot _____

Gas _____ Cu. Ft.

Dry Hole _____

Abandoned _____

Date

MAY 24 1950

19

J. E. TYRA

Scout

Kansas

Map No. _____ Sec. 33 Twp. 23 R. 5EWell No. 1 HeymannRex & Morris

Company

Contractor

SE SW SE

El. 1441

SECTION PLAT

Ft. from N. Line

330 Ft. from S. Line

Ft. from E. Line

990 Ft. from W. Line

Butler County

Location _____

Rig up _____

Drilling and Remarks:

15 $\frac{1}{2}$ " @ 210

13" @ 715

Lans. 1815

HFW 1815-20

8" @ 1855

Miss. 2420

RECORD

Cased _____ in., _____ ft.

Sand _____

Gas _____

Oil _____

Total Depth 2557

PRODUCTION

1st 24 hrs. Nat. _____

1st 24 hrs. after shot _____

Gas _____ Cu. Ft.

Dry Hole _____

Abandoned _____

Date

JUN 21 1950

19

J. E. TYRA

Scout

Viola 2555

HFV 2555-57 TD

D & A

Scout Cards
Land Small Map
Land Wall Map
Tracings
France Map
Pierce Map
Misc.

DATE: 1979

1518 11b

LOCATION

APR 28 1950

257

2500

RECORD









