

KANSAS


Greenwood

Form 51—5M—7-39—Palace

Section 31 Township 23 Range 12-E


Well No. #1 Shook

Company Henderson et al

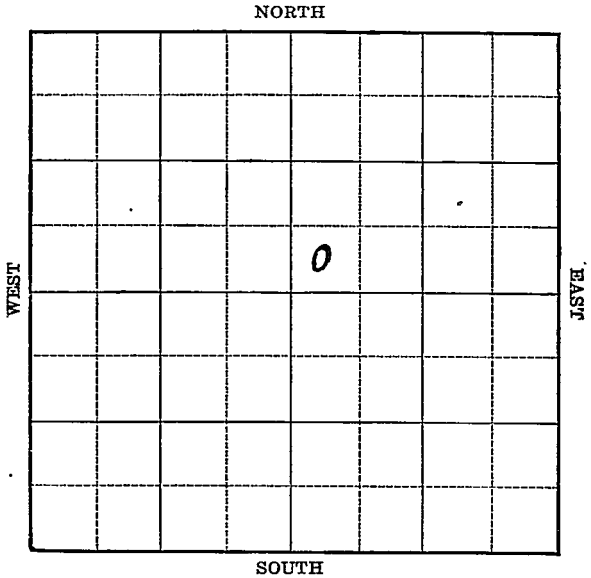

Henderson et al _____ Company

330 Ft. from W. Line

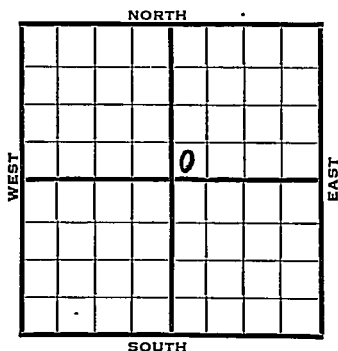[illegible]

Map No. 16 Sec. 31 Twp. 23 R. 12EWell No. 1 ShookHenderson etal Company

Contractor

FIRST REPORT

SW NE

 Ft. from N. Line330 Ft. from S. Line Ft. from E. Line330 Ft. from W. Line**SECTION PLAT**

		6	

Location Rig up

Drilling and Remarks:

Mach on Ground**RECORD**Cased in., ft.Sand Gas Oil Total Depth **PRODUCTION**1st 24 hrs. Nat. 1st 24 hrs. after shot Gas Cu. Ft.Dry Hole Abandoned

Date

APR 10 1940 19 S. J. LEWIS Scout

Map No. 16 Sec. 31 Twp. 23 R. 12 EWell No. 1 Shook

Henderson et al

Company

Contractor

ABANDONED

SW NE

Ft. from N. Line

330 Ft. from S. Line

Ft. from E. Line

330 Ft. from W. Line

SECTION PLAT

Location _____

Rig up _____

Drilling and Remarks:

*Mid's 1852**200' Water.*

RECORD

Cased _____ in., _____ ft.

Sand _____

Gas _____

Oil _____

Total Depth 1901

PRODUCTION

1st 24 hrs. Nat. _____

1st 24 hrs. after shot _____

Gas _____ Cu. Ft.

Dry Hole _____

Abandoned _____

Date

MAY 8 1940 19

S. J. LEWIS Scout