

Section 31 Township 23 Range 6 EWell No. # 1 WiebeCompany Barker et al

NORTH

		0					

SOUTH

WEST EAST

Butler KANSAS

SEC.	TWP.	R.
31	23	6E ✓

WELL NO.

1 Wiebe

FARM

COMPANY

Barker et al

CONTRACTOR

Wixson

_____ Ft. from N. Line

330


_____ Ft. from S. Line

990

_____ Ft. from E. Line

_____ Ft. from W. Line

SW SE NW

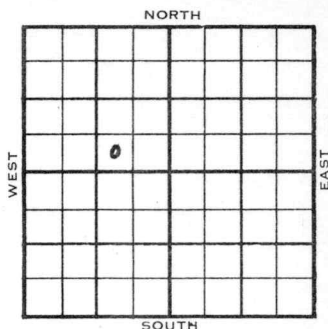

1954

ELEVATION

1459'

REPORT

3/31

Location

5/26

Spud 4-14-54 D & A TD 2425
 15" @ 194 13" @ 840 10" @ 1610
 Lans. 1665' KC 1940' 7" @ 2378
 Arb. 2409 TD 2425 D & A

ABANDONED

County Butler State Kansas
Sec. 31 (Blk.) 23 (Sur.) 6E Map No.
Operator Barker etal.
Well No. 1 Farm Wiebe

Elev. _____ Location SW SE NW



330 Ft. From S Line NW
990 Ft. From E Line Quarter

1st. Report MAR 31 1954

Completion _____


Remarks _____

Wixson - Contr.

Spudding Date _____

Drig. Data _____

Location

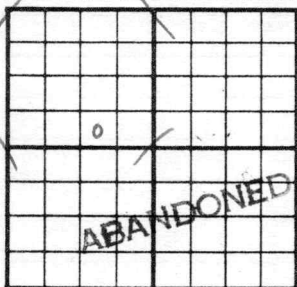County Butler State KansasSec. 31 (Blk.
Twp.) 23 (Sur.
Rge.) 6E Map No.Operator Barker etal.Well No. 1 Farm WiebeElev. 1459 Location SW SE NW330 Ft. From S Line NW990 Ft. From E Line Quarter

1st. Report

Completion MAY 26 1954Remarks Wixson - Contr.Spudding Date 4-14-54Drig. Data D & A TD 242515" @ 194 13" @ 840 10" @ 1610Lans. 1665 KC 1940 7" @ 2378Arb. 2409 TD 2425D & A