


NORTH

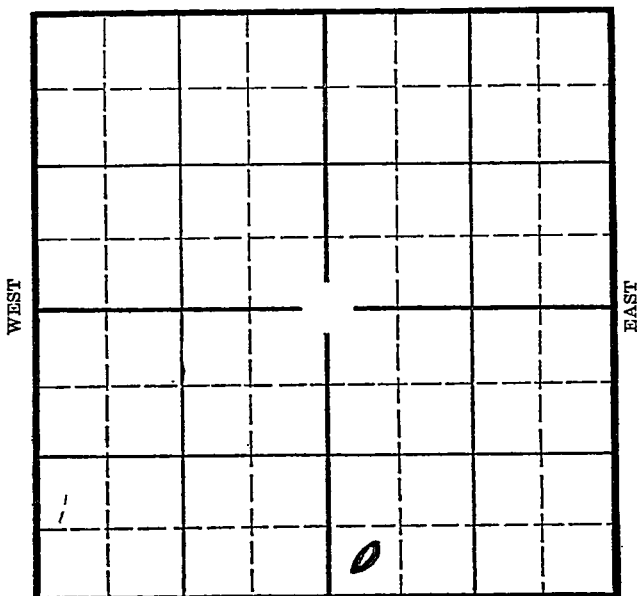

SOUTH

Drilling Remarks

Drilling Remarks

RECORD

Cased _____ in. _____ ft.

Sand_____

Gas_____

Oil_____

Total Depth_____

PRODUCTION

1st 24 hrs. Nat. _____

1st 24 hrs. after shot_____

Gas_____cu. ft._____

Dry Hole_____

Abandoned_____

Greenwood

Map No. KANSAS Sec. 31 Twp. 23 R. 12E


Well No. 1- Shook Farm
Ab Markers Company

 Ft. from N. Line

300 Ft. from S. Line

 Ft. from E. Line

300 Ft. from W. Line

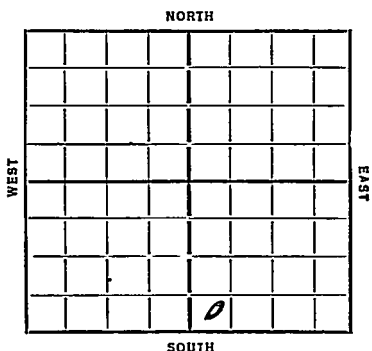

Date 1935 REPORT

6/5 Location
6/13 Moving
6/20 Rgn
6/28 Dlg 400
7/3 " 1075
7/11 " 1860
7/18 TL 1864 1887 to
Acidize
7/31 Top line 1864
T.D. 1887
1000 acid
35 oil 24 hrs

COMPLETED

Map No. 18 Sec. 31 Twp. 23 R. 12EWell No. 1- ShockAt Markus Company

Contractor

FIRST REPORTS**SECTION PLAT**

Ft. from N. Line

300 Ft. from S. Line

Ft. from E. Line

300 Ft. from W. Line

		0	

Location ✓

Rig up

Drilling and Remarks:

RECORD

Cased _____ in., _____ ft.

Sand _____

Gas _____

Oil _____

Total Depth _____

PRODUCTION

1st 24 hrs. Nat. _____

1st 24 hrs. after shot _____

Gas _____ Cu. Ft.

Dry Hole _____

Abandoned _____

Date

6-5-35 192 _____ Scout

Map No. 1a Sec. 31 Twp. 23 R. 12E

Well No. 1- Shook

H. Markus Company

Contractor

COMPLETED

SECTION PLAT

Ft. from N. Line

300 Ft. from S. Line

Ft. from E. Line

300 Ft. from W. Line

Location

Rig up

Drilling and Remarks:

1000 and

35 fth

RECORD

Cased _____ in _____ ft.

Sand TL 1864

Gas _____

Oil _____

Total Depth 1887

PRODUCTION

1st 24 hrs. Nat. _____

1st 24 hrs. after shot _____

Gas _____ Cu. Ft.

Dry Hole _____

Abandoned _____

Date

7-31-35 192

ORVAL MANNSCHRECK

Scout