


KANSAS

Map No. 2 Sec. 31 Twp. 23 R. 12EWell No. 2 Brook Farm
Ward Mc Ginnis Company

NORTH

WEST

EAST

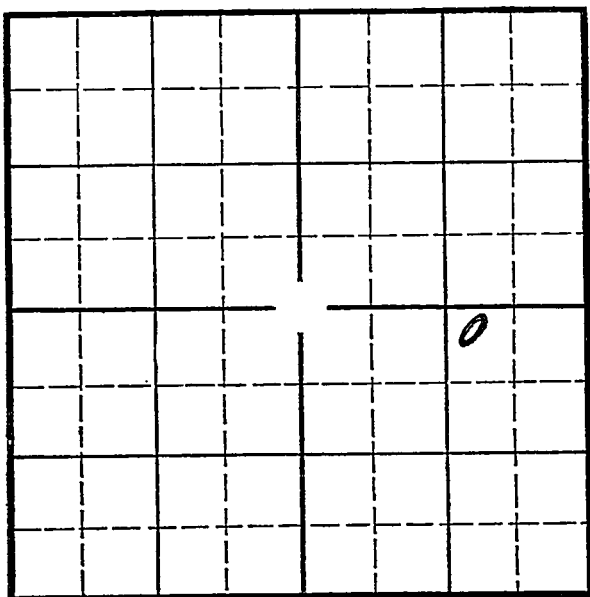

SOUTH

Location _____
Drilling Remarks _____Rig Up _____
Drilling Remarks _____

RECORD

Cased _____ in. _____ ft.

Sand _____

Gas _____

Oil _____

Total Depth _____

PRODUCTION

1st 24 hrs. Nat. _____

1st 24 hrs. after shot _____

Gas _____ cu. ft. _____

Dry Hole _____

Abandoned _____

Map No. KANSAS Sec. 31 Twp. 23 R. 12E
Well No. 2- Shook Farm
Ward Mc Ginnis Company

300 Ft. from N. Line

 Ft. from S. Line

1120 Ft. from E. Line

 Ft. from W. Line

NORTH									
SOUTH									

WEST

EAST

Date 1935 REPORT

9/20 Machine
10/3 825
10/9 TL 1845
TJ 1884

J. & A.

ABANDONED

Map No. 16 Sec. 31 Twp. 23 R. 12EWell No. 2- ShockWard McBurnis Company

Contractor

FIRST REPORTS

SECTION PLAT

300 Ft. from N. Line

Ft. from S. Line

1120 Ft. from E. Line

Ft. from W. Line

			①

Location

Rig up

Drilling and Remarks:

Machine

RECORD

Cased in, ft.

Sand

Gas

Oil

Total Depth

PRODUCTION

1st 24 hrs. Nat.

1st 24 hrs. after shot

Gas Cu. Ft.

Dry Hole

Abandoned

Date

ORVAL MANNSCHRECK

9-20-35 192

Scout

KANSAS

Map No. 12 Sec. 31 Twp. 23 R. 12EWell No. 2- ShookWard McKinnis Company

Contractor

ABANDONED

SECTION PLAT

300 Ft. from N. Line

Ft. from S. Line

1120 Ft. from E. Line

Ft. from W. Line

			0

Location

Rig up

Drilling and Remarks:

ND + F

RECORD

Cased TL in. 1845 ft.Sand TL

Gas

Oil

Total Depth 1884

PRODUCTION

1st 24 hrs. Nat.

1st 24 hrs. after shot

Gas Cu. Ft.

Dry Hole

Abandoned

Date

10-9-35 192

ORVAL MANNSCRAFT

Scout