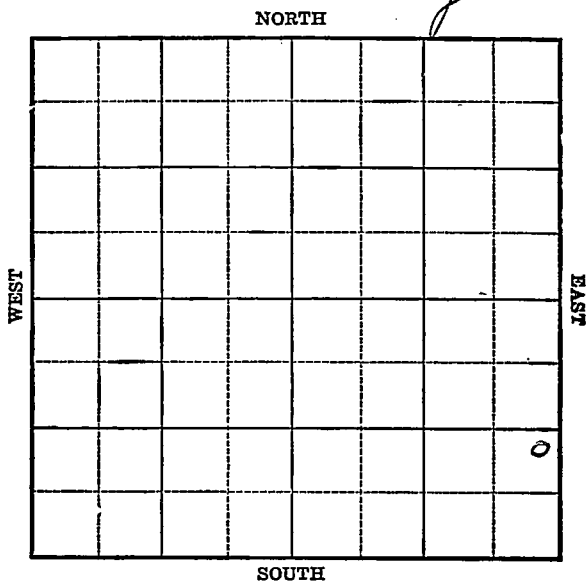


Map No. Kansas Sec. 33 Twp. 23 R. 13Well No. 1 Jensen Farm
Callahan & Dingle Company

Location _____

Drilling Remarks:

RECORD

Cased _____ in. _____ ft.

Sand _____

Gas _____

Oil _____

Total Depth _____

Rig Up _____

Drilling Remarks:

PRODUCTION

1st 24 hrs. Nat. _____

1st 24 hrs. after shot _____

Gas _____ cu. ft.

Dry Hole _____

Abandoned _____

Map No. Kansas Sec. 33 Twp. 23 R. 13

Well No. 1 Jensen Farm

Callahan + Surgee Company

NORTH

_____ Ft. from N. Line


1120 Ft. from S. Line

200 Ft. from E. Line

_____ Ft. from W. Line

WEST

EAST

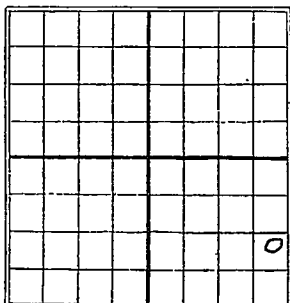

SOUTH

Date

1925

REPORT

3/24 Spud

5/15 Abandoned 1854

77 Map No. **KANSAS** Sec. **33** Twp. **23** R. **13**

Well No. **1 Jensen**

Callahan & Pingree Company

Contractor

FIRST REPORT

SECTION PLAT

----- Ft. from N. Line

1120 Ft. from S. Line

200 Ft. from E. Line

----- Ft. from W. Line

			6

Location -----

Rig up -----

Drilling and Remarks:

Spud.

RECORD

Cased ----- in., ----- ft.

Sand -----

Gas -----

Oil -----

Total Depth -----

PRODUCTION

1st 24 hrs. Nat: -----

1st 24 hrs. after shot -----

Gas ----- Cu. Ft.

Dry Hole -----

Abandoned -----

Date

M. A. BENEAR

3/24

192**5**

Scout

Map No. 27446 Sec. 33 Twp. 23 R. 13Well No. 1 Jorden
Callahan & Ingree Inc Company

Contractor

COMPLETED

SECTION PLAT

Ft. from N. Line

1126

Ft. from S. Line

200

Ft. from E. Line

Ft. from W. Line

ABANDONED

			0

Location

Rig up

Drilling and Remarks:

Dry hole 1480-1530Top line 1752'Dry & abandoned

RECORD

Cased _____ in., _____ ft.

Sand _____

Gas _____

Oil _____

Total Depth 1854'

PRODUCTION

1st 24 hrs. Nat. _____

1st 24 hrs. after shot _____

Gas _____ Cu. Ft.

Dry Hole ☒Abandoned ☒

Date

MAY 15 1925

192 CHAS. L. SHERWOOD

Scout